

COPIA  
EK 19  
5-29-62

MISSISSIPPI BOARD OF WATER COMMISSIONERS

WATER WELL DRILLERS LOG


COPIED

Date: May 29, 1962, Driller: Binney Water Well Serv. Co., Inc. (Name)

(1) Owner of Land	(2) Location	(3) Topography	(4) Purpose of Well	Description & Color of Material	Thickness in Feet	Depth in Feet
Edwin Weaver (Name)	4 miles East of Covington, St. Tam. Parish, La.	Hilly	Domestic	Red clay	7	7
				Gravel & Sand	23	30
				Clay & gravel	10	40
				Gravel	30	70
				Sandstone	3	73
				Sand	3	76
				Clay	17	90
				Layers of clay & sand	7	97
				All sand	70	137
Information upon completion of well						
(1) Diameter	6 inches					
(2) Total Depth	137 feet					
(3) Water Level	33 feet below top of ground					
(4) Cased to	14' 2" (Size 100-74)					
(5) Screen Size	20' length					
(6) Were any formations cased against pollution?	X yes					
If YES depth of formation from surface						
Why to prevent surface pollution						
Driller's Remarks: Land easy well back						

Edwin Weaver

COPIED

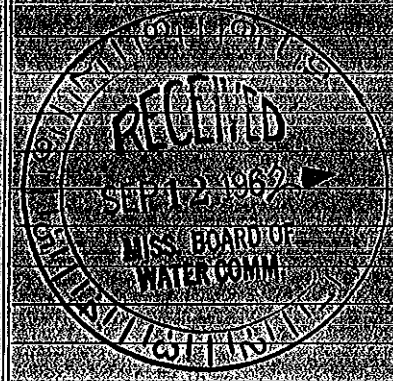

(Use Back Side)

Well No.

Mail this copy to Board of Water Commissioners 429 Miss. St. Jackson, Miss.