

Copiah
 K 36
 275-81
 E.A. # 265

MISSISSIPPI
 BOARD OF WATER COMMISSIONERS
 416 North State Street
 Jackson, Mississippi 39201

CODED

WATER WELL DRILLERS LOG

at Copiah county well located

date well completed

by Jack & Quim

county well located

LANDOWNER

description of formations encountered

from

to

(well address)

WELL LOCATION:

sec. 18 T. 1 N. R. 1 E.
6 miles East of Copiah
 (distance) (direction)

275 feet


WELL PURPOSE:

(Domestic, irrigation, municipal, industrial)

WELL COMPLETION DATA:

- (1) diameter (inches) 4
- (2) total depth (feet) 275
- (3) static water level (feet) _____
 below above
 top of ground
- (4) casing (material) (depth) _____
 If telescopic see back.
 (1) _____
- (5) screen (length) (depth to top) _____
 (size) (material) _____
- (6) pump (HP) (yield gpm) _____
 (type, power) _____
- (7) electric log (yes/no) _____
 (larger than running log) _____
- (8) show well bottom plugged _____

CODED

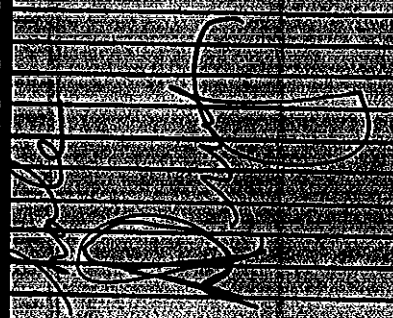

DEPT. OF NATURAL RESOURCES
 BUREAU OF LAND & WATER

APR 20 1987

OTHER REMARKS: