	STATE WELL REPORT	326
County: Opiah	Part 1	For Office Use Only:
Permit #:	Driller's Log Mississippi Department of Environmental Quality	Well #:K56
Driller: James M. Wells	Office of Land and Water Resources	Aquifer:
Date drilling completed: 8-30-18	P.O. Box 2309 Jackson, MS 39225-2309	E-Log #:
	(601)961-5210	
State Faux seguines that it	(601)360-0535 (fax)	
Department at the above address w	be prepared by the license holder responsible for t Ithin 30 days of completion of drilling of the well	he work and filed with the
Well Owner Informati (Landowner if borehole is not for	on Well or Bore	hole Location
\sim 1. 1/	u water well)	$_{\text{pritude}}$ 90° 15.3 W
	KING 31-35-05	90.15 03
Mailing Address:	Method of Lat/Long (check one	
8191 Brosty Creek	USGS quad, Hand-held G	
City Stal prings ND State	7057¼½¼, Sec Zip Code	34 TIN RIW
Telephone No. ()	Milesot	f
······································	(Distance) (Direction)	(Nearest Town)
ogs run (circle all applicable) No log run dame of organization running log(s): Purpose of borehole (circle one): Water V Seismic	Veil Geotechnical/Geological Investigation G Survey Other (describe)	round Source Heat Guilling 20 20
a flowing well, method of flow regulation	ion: Valve Other (describe)	
	above or below land surface Date measured: (circle one)	8.30.18
ethod of measurement (circle one)	el tape Electric tape Air line Other (describe): _	
ell depth: <u>85</u> Well grouted to a de	pth of: 10 feet Type of grout (circle one): N	eat Cement) Bentonite Mix
using length: <u>65</u> feet Casir	ng diameter:inches Type of cas	
reen length: <u>20</u> feet Scre	een diameter:inches Type of sci	
reen slot size: .008 inches	Setting depth: From <u>65</u> feet to	85
pe of completion (circle all applicable)		Natural Development
her (describe):		natural Development
p of lap pipe or reduction in casing:	feet	
	d or more than one screen, describe on next page	

.

· •

County: _	Copian	
Permit #:		


.

ł

	For C	office Use Only:
Well	#:	1456

The sketch below only required for water wells

If well telescopes, show depths on sketch.

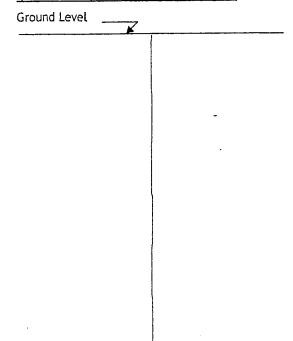

Description of formations encountered must be provided for all wells and boreholes, unless specifically exempted by regulations

Description of Formations Encountered	From (depth)	To (depth)
topsoil	Ground level	
Elay	1	50
Sand	50	85
		-

If more than one screen, show location of each on sketch

Sketch the property layout and include the f 1) the well location 2) any permanent structures on the pro 3) any roads, power lines, or other item 4) north arrow	perty that may aid in s that may aid in loc X WM	h locating the well cating the propert	l ay and the well	RECEIVED SEP 20 2018 BY OLIVIR
Landowner Name:	Young			
I HEREBY CERTIFY that the well/boreho requirements of the Mississippi Departm if applicable, and state laws.	le was drilled, cor nent of Environme	nstructed, and o ntal Quality and	completed in accord I the Mississippi Dep	ance with all applicable artment of Health regulations,
Dames IM. Wells 0000 Print Name of Responsible Licensee and	5889 9.	-17-18 Date	Jang	ture of Licensee

Form: OLWR-SWR-1A (4/13)

STATE WI	LL REPORT	
County: Copian	Part 2	For Office Use Only:
Pump Installer	's Completion Report	•
Mississippi Departine	ent of Environmental Quality and Water Resources	Well #:K56
Pata completedi \$.30.15). Box 2309	Aquifer:
Jackson	, MS 39225-2309 1)961-5210	Aquiter:
	360-0535 (fax)	L
This part of the report must be completed by a licensed water w of the report must be attached and both parts filed with the De	vell contractor or a licensed pun partment at the above address w	np installer. A copy of Part I ithin 30 days of well completion.
Well Owner Information	Well Lo	ocation
Owner Name: Jackie Hung	Latitude: <u>31°55,5 N</u> Lon	gitude: <u>4575.36</u>
Mailing Address:	Method of Lat/Long (check one)	: Conventional Survey,
	USGS quad, Hand-held GF	
Crystal Springs MS 39059		24 TIN RIW
Telephone No. ()	Miles of (Distance) (Direction)	(Nearest Town)
Pump Type	e (circle one)	
Submersible Turbine Air Lift Centrifugal Flowing Well .	let Piston Rotary Other (de	scribe):
Date Pump Installed: 8:30-18 Ra		
Is This Pump (circle one): New Repaired Replacement		
	e (circle one)	
Electric Diesel Gasoline Natural Gas Tractor PTO Wind	mill Other (describe):	
Horse Power Rating of Motor: Setting Depth	- <u>70</u> feet Number	of Stages:
	or Non Flowing Well	. /
Date Well Tested: 8-30-18	Duration of Pump Test (minim	um 4 hours): hours
Static Water Level (A): <u>45</u> Feet Below Land Surface	Pumping Water Level (B): _	70 Feet Below Land Surface
Drawdown [(B) - (A)]: 52 Feet Below Land Surfa		
Method of measurement (circle one); Steel tapy Electric tap		
Pump Test Data	for Flowing Well	
Measured shut in head:feet.	-	
	feet after	hours of pumping
Mahar I		
meter ir	statiation	RENDA
Meter Manufacturer:	Meter Serial Number:	SEP 1-
Meter Model Number/Name:	Type of Meter:	
Totalizer Register Unit and Multiplier Factor (AF x .001, gal >	: 1000, etc):	BI
Well yielded GPM with a drawdown of Meter in Meter Manufacturer: Meter Model Number/Name: Totalizer Register Unit and Multiplier Factor (AF x .001, gal >) Installation Date: Meter installed by: Installation Date: New Repaired		
is This Meter (circle one): New Repaired Replacemen	t	
Important: By submitting the above information you are cer For agricultural wells, a list of app	tifying that this meter was instan oved meters is on the MDEQ w	lled to manufacturer standards. ebsite.
I HEREBY CERTIFY that the above statements are true to the	best of my knowledge.	
Tames M. Wells 00005789 Print Name of Pump Installer and License No. (if applicable)		· · · · / L · · · · · · · · · · · · · ·

• •

•

٠

Form: OLWR-SWR-1B (4/13)