

COPIA MISSISSIPPI BOARD OF WATER COMMISSIONERS

E K 2000
4-4-62

WATER WELL DRILLERS LOG

Date April 4, 1962, Driller: Bunney Water Well Security Coplan
(Name)

(1) Owner of Land: J. J. Bass
(Name)
Crystal Springs, Miss.
(City)
Harmony Road
(2) Location: 1/4 Sec. 15 NW
(Township) (Range)
8 miles West of Crystal Springs
(distance) (direction) (Nearest Town)
(3) Topography: Hilly
(Hilly) (Flat) (Level)
(4) Purpose of Well: Domestic
(Domestic) (Irrigation) (Municipal) (Industrial) (Other)

Description & Color of Material (sand, clay, red clay, shell, etc.)	Thickness Feet	Depth Feet
Clay & topsoil	4	4
Gravel & sand	18	22
Red sand	8	30
Gravel & rocks	34	64
Rock	1	65
Gravel	3	68
Yellow sand	4	72
Blue clay	11	83
Hard rock	5	88
Gray shale	11	99
Red & white pipe clay	20	119
Fine sand layers	25	140
All Sand	22	162

Information upon completion of well:

(1) Diameter: 4 inches

(2) Total Depth: 162 feet

(3) Water Level: 119 feet below top of ground


(4) Cased to: 155 ft. Size: 2"

(5) Screen: Size: 2" Length: 5'

(6) Were any formations sealed against pollution?
 yes no

If YES depth of formation from surface _____
Why: To prevent surface pollution

Driller's Remarks:

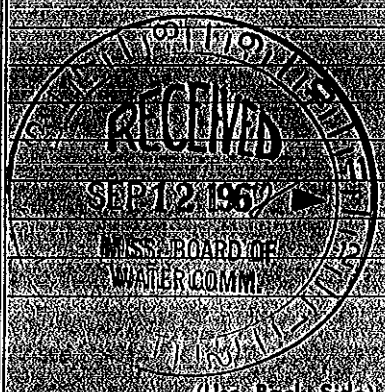

Well No.

Mail this copy to Board of Water Commissioners 429 Miss. St. Jackson, Miss.