

LOPIAH MISSISSIPPI BOARD OF WATER COMMISSIONERS

E K 200
6-6-63

WATER WELL DRILLERS LOG

Date: Time **6:00**, 1963, Driller: **Ben Burney** County: **Copiah**
(Name)

(1) Owner of land: **Beatrice Chandler**
(Name)
Route 2, Harmony Road, Coy. Spg.
Bur's Loop
(2) Location: **1/2** mi. **W** of **Harmony**
(distance) (direction) (Nearest town)
5 miles **East** of **Coy. Spg.**
(distance) (direction) (Nearest town)
(3) Topography: **Hilly**
(Hilly) (Flat) (Level)
(4) Purpose of Well: **Domestic**
(Domestic, Irrigation, Municipal, Industrial, Other)

Description & Color of Materials Sand, Clay, Red Clay, Shell, etc.	Thickness Feet	Depth Feet
Topsoil & Clay	13	13
Black Marl	11	24
Sand Layers	14	38
White & Yellow Clay	7	45
Shale & Pea Gravel	15	60
Yellow & White Sand	44	104
Water Strata	11	115
Hard Gray Clay	7	122

Information upon completion of well:

(1) Diameter: **6 1/2** inches

(2) Total Depth: **122** feet

(3) Water Level: **29** feet below top of ground

(4) Cased to: **107 1/2** feet, Size: **7 1/2** inches


(5) Screen: Size: **1/4** inch, Length: **17** feet

(6) Were any formations sealed against pollution?
 yes no

If YES depth of formation: **From surface**

Why to prevent contamination: **no pollution**

Drillers Remarks:

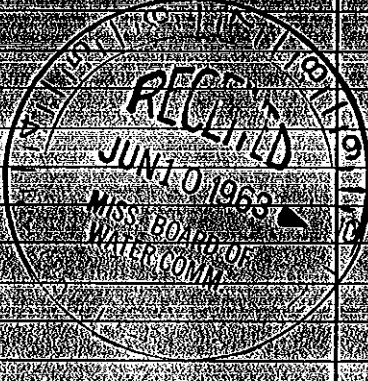

(Use Back Side)

Well No

Mail this copy to Board of Water Commissioners 429 Miss. St. Jackson, Miss.