

COPIAH MISSISSIPPI BOARD OF WATER COMMISSIONERS

K 2000
 7-2-64

WATER WELL DRILLERS LOG

Date: July 2, 1964 Driller: Bimney Water Well Serv. Co. Copiah

(Name)

(1) Owner of land: <u>Mary Renbarrt</u> (Name)	Description & Color of Materials Sand, Clay, Red Clay, Shell, etc.	Thick- ness (Feet)	Depth (Feet)
	Red clay top soil	8	8
Rt. 2, Box 678-A, Gay Mills Station, (Address)	Gravel and red sand	16	24
Brookhaven, Miss. (Nearest Town)	Red gravel and sand	12	36
(2) Location: <u>1/2</u> <u>18</u> miles East of Crystal Springs (distance) (direction) (Nearest Town)	Big gravel and sand	24	60
	Loose fine sand	20	80
(3) Topography: <u>Hilly</u> (Hilly) (Flat) (Level)	Light white sand	22	102
(4) Purpose of Well: <u>Domestic</u> (Domestic Irrigation Municipal/Industrial/Other)			


Information upon completion of well:

- (1) Diameter: 4 1/2 inches
- (2) Total Depth: 102 feet
- (3) Water Level: 52 feet below top of ground
- (4) Cased to: 90 feet. Size: 2 1/2"
- (5) Screen Size: 20 mesh. Length: 5 1/2 feet
- (6) Were any formations sealed against pollution?
 yes, no

If YES depth of formation: 5 1/2 feet from surface

Why: To prevent surface pollution

Driller's Remarks:

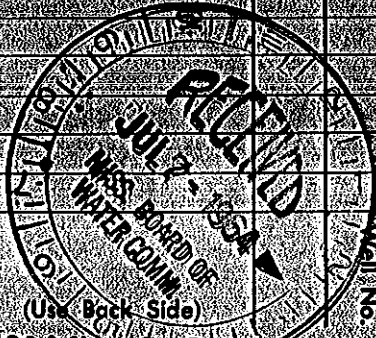

Mail this copy to Board of Water Commissioners 429 Miss. St. Jackson, Miss.