

COPIAH MISSISSIPPI BOARD OF WATER COMMISSIONERS

E K 2006
9-7-65

WATER WELL DRILLERS LOG

Date: Sept. 7, 1965, Driller: Erney Well Ser, Inc County: Copiah

(Name)

(1) Owner of Land: <u>H. O. Strainzer</u>	Description & Color of Materials (Sandy, Clay, Red Clay, Shell, etc.)	Thickness (Feet)	Depth (Feet)
(Name)	Red top soil	10	10
<u>Crystal Springs, Miss.</u>	Red sand	22	32
(Address)	Blue gravel	38	70
(2) Location: <u>1/4 Sec. 11W T. 1 R.</u>	Water sand	34	104
<u>3 miles East</u> of <u>Crystal Springs</u>			
(distance) (direction)			
(3) Topography: <u>Hilly</u>			
(Hilly) (Flat) (Level)			
(4) Purpose of Well: <u>Domestic</u>			
(Domestic Irrigation Municipal Industrial Other)			


Information upon completion of well:

- (1) Diameter: 4 1/2 inches.
- (2) Total Depth: 104 feet.
- (3) Water Level: 76 feet below top of ground.
- (4) Cased to 97 Size 4 1/2
- (5) Screen Size 4 1/2 Length 7 1/2
- (6) Were any formations sealed against pollution?
X yes no

If YES, depth of formation from surface

Why to prevent surface pollution

Drillers Remarks: well seal used

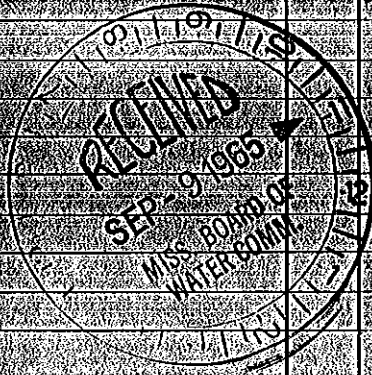

(Use Back Side)

Well No.

Mail this copy to Board of Water Commissioners 429 Miss. St. Jackson, Miss.