

COPIAH MISSISSIPPI BOARD OF WATER COMMISSIONERS

4-21-65

WATER WELL DRILLERS LOG

Date: April 21, 1965, Driller: Binney Water Well Serv. County: Copiah

(1) Owner of land: Jesse Wheeler
(Name)

Rt. 2, Crystal Springs, Miss.
(Address)

Ma this Road
(Location)

1/4 miles South of Crystal Springs
(distance) (direction) (Nearest Town)

(3) Topography: Hilly
(Hilly) (Flat) (Level)

(4) Purpose of Well: Domestic
(Domestic, Irrigation, Municipal, Industrial, Other)

Description & Color of Material <small>(Sand, Clay, Red Clay, Shell, etc)</small>	Thickness <small>(Feet)</small>	Depth <small>(Feet)</small>
Clay gravel	12	12
Sand gravel	10	22
Red sand & clay	14	36
White sand	26	62
Iron rock	1	63
Layers clay & sand	14	77
Sands tone	1	78
Grey clay	8	86
Water Sand	16	102

Information upon completion of well

(1) Diameter: 6 inches

(2) Total Depth: 102 feet

(3) Water Level: 25 feet below top of ground

(4) Cased to: 88' Size: 4"


(5) Screen: Size: 1/2" Length: 15'

(6) Were any formations sealed against pollution?
 yes, no

If YES depth of formation: from surface

Why: sanitary well seal used

Drillers Remarks:

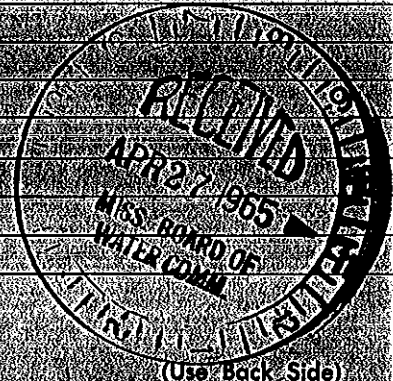

Well No.

Mail this copy to Board of Water Commissioners 429 Miss. St. Jackson, Miss.