

Copiah  
L 9  
2-21-68  
M.G.S.

MISSISSIPPI  
 BOARD OF WATER COMMISSIONERS **CODED**  
 416 North State Street  
 Jackson, Mississippi 39201  
 WATER WELL DRILLERS LOG

2-21-68 1968 Griner Drill, Inc. Copiah  
 date well completed firm name county well located


LANDOWNER: Harmon  
Ridge water association

description of formations encountered	from	to
<u>Top Soil</u>	<u>101'</u>	<u>10'</u>
<u>Sand and Gravel</u>	<u>128'</u>	<u>118'</u>
<u>Clay</u>	<u>135'</u>	<u>7'</u>
<u>Sand</u>	<u>163'</u>	<u>28'</u>
<u>Clay</u>	<u>178'</u>	<u>15'</u>
<u>Sand</u>	<u>200'</u>	<u>22'</u>
<u>Clay of small sand streaks</u>	<u>333'</u>	<u>133'</u>

(mailing address)  
 WELL LOCATION:  
 sec. 10 T 1 N R 1 E  
 S W  
 (distance) miles (direction) of (nearest town)

WELL PURPOSE:  
 (Home, Irrigation, municipal, Industrial)

WELL COMPLETION DATA:  
 (1) diameter (inches) 9 5/8  
 (2) total depth (feet) 200'  
 (3) static water level (feet) 121' below top of ground  
 (4) casing Steel 134' (material) (depth)  
9 5/8" (size) If telescope see back.  
 (5) screen 40' 142' (length) (depth to top)  
6" S.S. (size) (material)  
 (6) pump 1.0 1.50 (HP) (yield gpm)  
Electric (type power)  
 (7) electric log Yes (yes or no)  
Miss. F.W.S. (organization running log)  
 (8) how well bottom plugged Back  
Wagon Valve

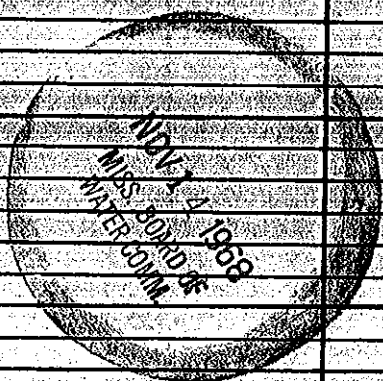

DRILLERS REMARKS: