

COPIAH MISSISSIPPI BOARD OF WATER COMMISSIONERS

ELI
3-31-65

WATER WELL DRILLERS LOG

CODED

Date: March 31, 19 65, Driller: Burney Water Well Serv. County: Copiah

(Name)

(1) Owner of Land: <u>Clemon Sojourner</u> (Name)	Description & Color of Materials Sand, Clay, Red Clay, Shell, etc.	Thick- ness Feet	Depth Feet
<u>Route 1, Georgetown, Miss.</u> (Address)	<u>Topsoil, gravel & pipe clay</u>	<u>8</u>	<u>18</u>
<u>Harmony Road</u> (Address)	<u>Hard pan or rock</u>	<u>8</u>	<u>26</u>
(2) Location: <u>SW 1/4, NW 1/4, Sec 19 1N1E</u>	<u>Red sandy formation</u>	<u>56</u>	<u>82</u>
<u>7 miles east</u> of <u>Crystal Springs</u> (distance) (direction) (Nearest Town)	<u>Water Sand med.</u>	<u>40</u>	<u>122</u>
(3) Topography: <u>Hilly</u> (Hilly) (Flat) (Level)			
(4) Purpose of Well: <u>Domestic</u> (Domestic Irrigation Municipal, Industrial, Other)			

Elev 370' Topo


Information upon completion of well:

- (1) Diameter 6 inches.
- (2) Total Depth 122 feet.
- (3) Water Level 66 feet below top of ground.
- (4) Cased to 109', Size 4"
- (5) Screen: Size 2 1/2", Length 10'
- (6) Were any formations sealed against pollution?
X yes, no.

If YES depth of formation from surface

Why sanitary well seal used

Drillers Remarks:

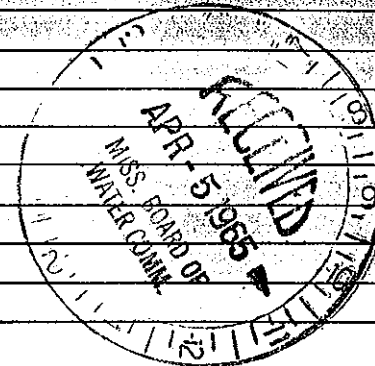

(Use Back Side)

Well No.

Mail this copy to Board of Water Commissioners 429 Miss. St. Jackson, Miss