

COPIAH MISSISSIPPI BOARD OF WATER COMMISSIONERS

L 14  
3-2-61

WATER WELL DRILLERS LOG

CODE

Date: March 2, 19 61, Driller: Burney Water Well Ser. County Copiah

(Name)

(1) Owner of Land: <u>Homer Slay</u> (Name)		Description & Color of Materials Sand, Clay, Red Clay, Shell, etc.	Thickness (Feet)	Depth (Feet)
<u>Crystal Springs, Miss.</u> (Address)		Topsoil	15	15
<u>Hopewell Road</u> (Address)		Sand	13	28
(2) Location: <u>1/4, NE 1/4, Sec. 8 T14N R16E</u>		Blue clay	7	36
<u>8</u> miles <u>East</u> of <u>Crystal Springs</u> (Distance) (Direction) (Nearest Town)		Rock	1	36
(3) Topography: <u>Hilly</u> (Hilly) (Flat) (Level)		Blue clay	32	68
(4) Purpose of Well: <u>Domestic</u> (Domestic Irrigation, Municipal, Industrial, Other)		Brown soft formation	7	75
		Blue clay	13	85
		Layers sand	7	92
		Clay	6	98
		Layers sand & clay	5	103
		All sand	3	116
		Blue shale or chalk	2	118


Information upon completion of well:

- (1) Diameter 4 inches.
- (2) Total Depth 118 feet.
- (3) Water Level 26 feet below top of ground.
- (4) Cased to 110', Size 2"
- (5) Screen Size 2", Length 5'
- (6) Were any formations sealed against pollution?  
X yes,        no.

If YES depth of formation From surface

Why To prevent surface pollution

Drillers Remarks:

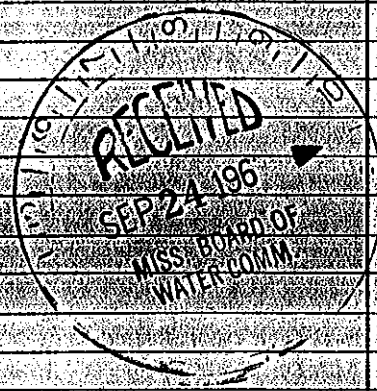

(Use Back Side)

Well No.