

**COPAH**  
**L22**  
**10-28-83**  
**ELB-F 285**


MISSISSIPPI  
 BOARD OF WATER COMMISSIONERS  
 416 North State Street  
 Jackson, Mississippi 39201

**CODED**

**WATER WELL DRILLERS LOG**

date well completed: **10-28-83** firm name: **43 Gumwellson** county well located: **COPAH**

| LANDOWNER              | description of formations encountered | from       | to         |
|------------------------|---------------------------------------|------------|------------|
| <b>KOPPERS SAWMILL</b> | <b>Silt &amp; gravel</b>              | <b>0</b>   | <b>50</b>  |
| (mailing address)      | <b>CLAY</b>                           | <b>50</b>  | <b>80</b>  |
|                        | <b>SAND</b>                           | <b>180</b> | <b>210</b> |

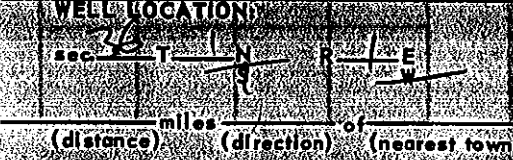

**WELL PURPOSE:**  
 (Home, Irrigation, Municipal, Industrial)

- WELL COMPLETION DATA:**
- (1) diameter (inches) **4 1/2**
  - (2) total depth (feet) **210**
  - (3) static water level (feet) **4** feet above top of ground
  - (4) casing (material) **PVC** (depth) **200**  
if telescopic see back (size)
  - (5) screen (length) **10'** (depth to top) **20'**  
(size) (material)
  - (6) pump (HP) \_\_\_\_\_ (yield/gpm) \_\_\_\_\_  
(type power)
  - (7) electric log (yes or no) \_\_\_\_\_
  - (organization running log) \_\_\_\_\_
  - (8) how well bottom plugged **BSW**

**CODED**

DEPT. OF NATURAL RESOURCES  
 BUREAU OF LAND & WATER RESOURCES

NOV 7 1983

**RECEIVED**