

COPIA

MISSISSIPPI BOARD OF WATER COMMISSIONERS

L 2000  
9-8-60

WATER WELL DRILLERS LOG

Date: Sept 8, 1960, Driller: Burney Water Well Serv. County Copiah  
(Ben Burney & Son)

(1) Owner of Land: Fred Miller  
(Name)  
Route 2, Crystal Springs, Miss.  
(Address)

(2) Location: 1/4 Sec 11E  
Hopewell  
\_\_\_\_\_ miles \_\_\_\_\_ East of Crystal Springs  
(Elev. or) (Direction) (Nearest town)

(3) Topography: Hilly  
(Hilly) (Flat) (Level)

(4) Purpose of Well: Domestic  
(Domestic, Irrigation, Municipal, Industrial, Other)

Information upon completion of well:

(1) Diameter 4 inches.

(2) Total Depth 82 feet.

(3) Water Level 64 feet below top of ground.

(4) Cased to 77, Size 2"

(5) Screen: Size 2", Length 5 ft

(6) Were any formations sealed against pollution?  
X yes, \_\_\_\_\_ no.


If YES depth of formation 16ft.

Why Small gravel & sand

Drillers Remarks: Above Depth sealed with 4" plastic casing.

Depth Interval (Feet)	Thickness (Feet)	Depth (Feet)
0 - 6	6	6
6 - 16	10	16
16 - 19	3	19
19 - 29	10	29
29 - 38	9	38
38 - 46	8	46
46 - 52	6	52
52 - 68	16	68
68 - 82	14	82

Drillers Remarks: 16" 4" plastic casing  
2 pc 2" casing  
Cylinder  
3" added at top

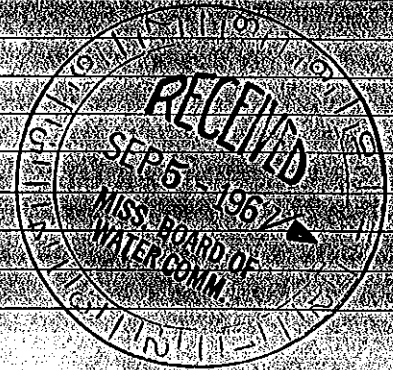

(Use Back Side)

Well No.

Mail this copy to Board of Water Commissioners 429 Miss. St. Jackson, Miss.