

COPIAH MISSISSIPPI BOARD OF WATER COMMISSIONERS

L 2003

8-13-64

WATER WELL DRILLERS LOG

Date: 8-13-64, 19____, Driller: BEN BURNETT, County COPIAH


(Name)

(1) Owner of Land: Came Barlow
(Name)
Harmony Road Crystal Springs
(Address)
(2) location: 31 10 12
1/4, 1/4, Sec. T. R.
1 1/2 miles West of Honolulu
(Distance) (direction) (Nearest Town)
(3) Topography: Hilly
(Hilly) (Flat) (Level)
(4) Purpose of Well: Domestic
(Domestic, Irrigation, Municipal, Industrial, Other)

Description & Color of Materials (Sand, Clay, Red Clay, Shell, etc.)	Thickness (Feet)	Depth (Feet)
CLAY TOP SOIL	8	8
RED SAND	20	28
RED & GREY SAND	25	53
IRON ROCK	1	54
PURE CLAY	3	57
HARD ROCK	4	61
BLUE CLAY	11	72
ROCK LAYERS	12	84
FINE SAND LAYERS	3	87
Hard Shale or Limestone	36	123
FINE SAND LAYERS	7	150
HARD BLUE CLAY	10	160
LINESTONE	10	170
FINE SAND LAYERS	10	180
ALL FINE TIGHT SAND	18	198
HARD BLUE SHALE	4	202

Information upon completion of well:

(1) Diameter 4" inches.
(2) Total Depth 198' feet.
(3) Water Level 85' feet below top of ground.
(4) Cased to 191', Size 2"
(5) Screen: Size 2 1/2" Length 5'
(6) Were any formations sealed against pollution?
X yes, no.
If YES depth of formation from surface _____
Why to prevent pollution from the surface.
Drillers Remarks: _____

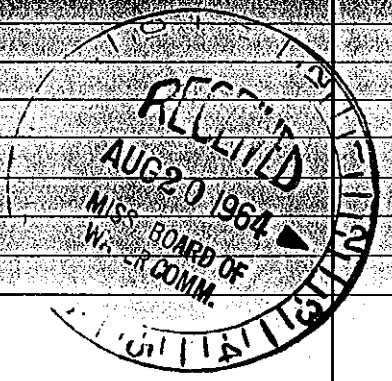

(Use Back Side)

Well No.

Retain this copy for your office files.