


M 5
3-4-60

WATER WELL DRILLERS LOG

COPIAH
5th

Date: 3-4-1960, Driller: Ben Burney & Son, Copiah, Miss.
Copiah Game Area Well. (Name)

(1) Owner of Land: Game & Fish Commission (Name) Box #451, Jackson, Miss. (Address)	Description & Color of Materials Sand, Clay, Red Clay, Shell, etc.	Thick- ness Feet	Depth Feet
(2) Location: 1/4 SW 1/4, Sec 24, T10N R5E 20 miles West of Hazlehurst (distance) (direction) (Nearest Town)	Top soil & red clay	28	28
(3) Topography: Hilly (Hilly) (Flat) (Level)	Layers red sand & clay	5	33
(4) Purpose of Well: Domestic (Domestic, Irrigation, Municipal, Industrial, Other)	Hard blue clay	27	60
	Layers of fine sand	9	69
	Tight grey shale	39	108
	Coarse water strata	14	122
	Chalk or grey shale	13	135
	End of well.		

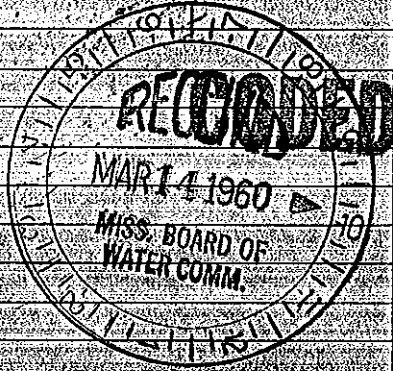

Information upon completion of well:

(1) Diameter 4" inches.

(2) Total Depth 135 feet.

(3) Water Level 81 feet below top of ground.

(4) Cased to 135 ft., Size 2"

(5) Screen: Size 2" No 7, length 10 feet.

(6) Were any formations sealed against pollution?
yes yes, no.

If YES depth of formation 70 feet.

Why Because of seepage to water strata.

Drillers Remarks: Well disinfected with Penasalt Perchlorin
Well developed for 4 hrs. until clear. Pumping at 400 gal. per. hour.

Well No.

(Use Back Side)