	State wen keport			
county: Copiah	Part 1	For Office Use Only:		
Permit #:	Mississippi Department of Environmental Quality	Aquifer:		
GRENN WATER WELL &	Office of Land and Water Resources P.O. Box 10631	Well #: N 15		
Driller: SUPPLY, INC.	Jackson, MS 39289-0631			
Date drilling completed: 3-26-13	(601)961-5210	L. S. Elevation:		
L	(601)354-6938 (fax)	E-log #:		
State Law requires that this ren	art he prepared by the driller in detail and filed a	with the Department within		
State Law requires that this report be prepared by the driller in detail and filed with the Department within 30 days of completion of drilling of the well.				
Well Owner Inform	ation Wel	Location		
Owner Name Amanda Hal	Latitude: 31 º 49:89	3 Longitude: 90° 35, 908		
Mailing Address: 8113 Barlo		·		
·	USGS guad, Hand-held	GPS.) Survey-grade GPS		
Hazlehurst N	15 39083	- L L L L L L L L L L L L L L L L L L L		
City Sta	te Zip Code SW SW	VIWN 10 N Rng 6 E		
Telephone No. (601) 500 - 135	Distance Direction	Nearest Town		
100phone 140. (801) 300 133	$\frac{\mathcal{L}}{\mathcal{L}}$ Miles $\frac{\mathcal{L}}{\mathcal{L}}$	of Hazelhurst		
	Well Data			
Purpose of Well (circle one) Home Inc	lustrial Public Supply Irrigation Fish Culture	Other		
	·····	**************************************		
	Date well drilling completed:	26-13		
If flowing, method of flow regulation: Va	lve Other (describe)			
Static Water Level: 72 feet al	pove on below (circle one) land surface Date measured:	3-26-13		
Method of Measurement (circle one) s	teel tape electric tape air line other:			
	pth: 250 Well grouted to a depth of _			
		feet feet		
Type of grout (circle one): Cement	Bentonite Mix			
Casing length: 230 feet Casin	ng diameter:inches Type of casing:	PVC		
Screen length: 20 feet Screen diameter: 4 inches Type of screen: PVC				
Screen slot size: -0/0 inches	Setting depth: From 230 feet to 2	50 feet		
Type of completion (circle all applicable):	Gravel packed Underreamed Telescoped Open	hole Natural Development		
	Other (describe):			
Top of low mine and a treat				
Top of lap pipe or reduction in casing:	feet. If telescoped or more than one scre	een, describe on back of page		
Logs run (circle all applicable): No log run	n Electric Gamma Ray Density Sonic Neutron	Other:		
Name of organization running log(s):				
I certify that the well was drilled, constr	ucted, and completed in accordance with all applicable	requirements of the Missississ		
Department of Environmental Quality a GRENN WATER WELL & SUPPL	and/or the Mississippi Department of Health regulations	and state laws.		
BRIAN D. MOCLENION IND	00000000	10-1		


Print Name of Water Well Contractor and License No.

Signature of Water Well Continues

Ground Level				
	·			
· · · · · · · · · · · · · · · · · · ·	· · · · · · · · · · · · · · · · · · ·			
	* .			
j				

Description of Formations Encountered	From	То
white Clay	O	30
hlus clay	30	225
Sand w/ clay streams	225	7-1
733600	10	270
	+	
		-
	+	
	 	\dashv
	\vdash	

If more than one screen, show location of each on sketch

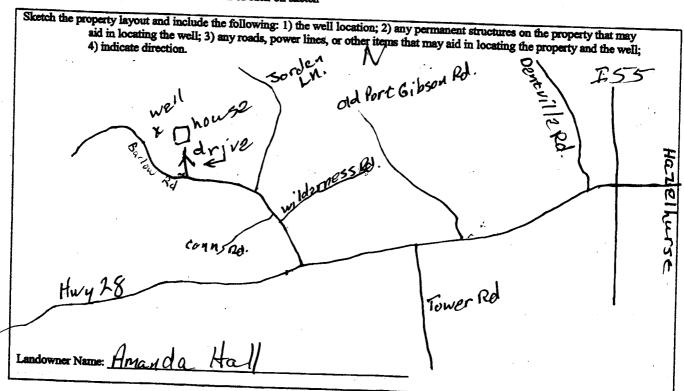

Bruke McClendon 664
Signature of Water Well Contractor

STATE WELL REPORT Part 2

County: Copic Pump Inst Mississippi Depa Office of I Driller: GRENN WATER WELL

Pump Installer's Completion Report
Mississippi Department of Environmental Quality
Office of Land and Water Resources
P.O. Box 10631
Jackson, MS 39289-0631
(601)961-5210
(601)354-6938 (fax)

For Office Use Only:		
Aquifer:		
Well #:	NIS	
Elevation:		

Date completed: 3/28/13	(601)354-6938 (fax) Elevation:			
This report should be prepared by the pump installer in detail and filed with the Department within 30 days of the installation of pump.				
Well Owner Information	Well Location			
Owner Name: Amanda Hall	Latitude: 31 49.083 Longitude: 90° 35.908			
Mailing Address: 8113 Barlow Rd.	Method of Lat/Long (circle one): Conventional Survey,			
	USGS quad, Hand-held GPS, Survey-grade GPS			
Hazlehurst MS 30 City State Zi	1083 SE 1/2 SE 1/2 Sec 15 Twn 1DN Rng 6E			
City State Zi	Distance Direction Nearest Town			
Telephone No. (60/) 500 -1350	12 Miles Sw of Hazlehurst			
Pump Type Circle one	Power Type			
	Circle one			
Air Lift Jet Submer	Diesel Engine Gasoline Engine Natural Gas			
Bucket Piston Turbine	Electric Motor Hand Tractor PTO			
Centrifugal Rotary Flowing	Well Windmill Other (specify):			
Other (specify):	Horse Power Rating of Motor:			
Date Pump Installed: 3/28/13	Setting Depth: 105 feet			
Rated Pump Capacity: Gallons I	Per Minute Number of Stages:			
Pump Test Data	Method of Measuring Water Level			
Date Well Tested: 3/23/13	Circle one			
Static Water Level (A): 72 Feet Below La	Air Line Electric Measuring Line Steel Tape			
Pumping Water Level (B): 76 Feet Below La	i de la companya de			
Drawdown [(B) – (A)]:Feet Below La				
Test Pumping Rate: 19 Gallons F	Jan Will a diawdown of			
Duration of Pump Test (minimum 4 hours):	hoursfeet afterhours of pumping			
I HEREBY CERTIFY that the above statements are true to the best of my knowledge.				

I HEREBY CERTIFY that the above statements are true to the best of my knowledge.

WILLIAM L. HARDIN, V, UNR-00000802

Print Name of Pump Installer and License No. (if applicable)

Signature of Pump Installer