


COPIAH  


MISSISSIPPI BOARD OF WATER COMMISSIONERS

WATER WELL DRILLERS LOG

11-22-61

Date: Nov 22, 19 61, Driller: Burney Water Well Serv County Copiah  
 (Name)

	Description & Color of Materials Sand, Clay, Red Clay, Shell, etc.	Thick- ness Feet	Depth Feet
(1) Owner of Land: <u>A. E. Barlow</u> (Name)	Topsoil & pipe clay	20	20
<u>Hazlehurst, Miss.</u> (Address)	Grey clay & sand	20	40
(2) Location: <u>Highway 20 31 10 78</u> <u>1/4, 1/4, Sec. T R</u>	Grey clay	28	68
<u>20 miles West</u> of <u>Hazlehurst</u> (distance) (direction) (Nearest Town)	Sand layers	4	72
(3) Topography: <u>Hilly</u> (Hilly) (Flat) (Level)	Grey clay	11	83
(4) Purpose of Well: <u>Domestic</u> (Domestic Irrigation Municipal, Industrial, Other)	Sand	7	90
	Blue & grey clay	14	104
	Tight hard formation	33	137
	Rock	3	140
	Hard formation	40	180
	Fine sand	20	200


Information upon completion of well:

- (1) Diameter 6 inches.
- (2) Total Depth 200 feet.
- (3) Water Level 68 feet below top of ground.
- (4) Cased to 138', Size 4"
- (5) Screen: Size 2", Length 10'
- (6) Were any formations sealed against pollution?  
 yes,  no.

If YES depth of formation From surface

Why To prevent surface pollution

Drillers Remarks: 4" Sanitary well seal

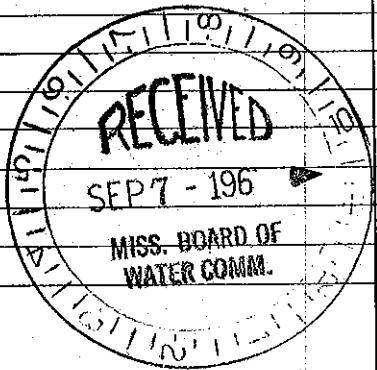

(Use Back Side)

Well No.