

COPIAH MISSISSIPPI BOARD OF WATER COMMISSIONERS

12-10-64

WATER WELL DRILLERS LOG

Date: Dec. 10, 1964, Driller: BURNEY WATER WELL SERV. County: Copiah

(Name)

	Description & Color of Materials Sand, Clay, Red Clay, Shell, etc.	Thick- ness Feet	Depth Feet
(1) Owner of Land: Thompson Barlow (Name)	Red top soil	4	4
Rt. 4, Box 98, Hazlehurst, Miss.	Red sand	6	10
(Address) 35106E	Gravel and red sand	50	60
(2) Location: 1/4, 1/4, Sec. T R	Rock	1/2	60 1/2
1/4 miles West of Hazlehurst	Sand and pea gravel	29 1/2	90
(distance) (direction) (Nearest Town)	Sand or iron stone	60	150
(3) Topography: Hilly	Pipe clay	20	170
(Hilly) (Flat) (Level)	White sand with clay layers	32	202
(4) Purpose of Well: Domestic	Sand and clay	38	240
(Domestic Irrigation Municipal, Industrial, Other)	Clay	6	246


Information upon completion of well:

- (1) Diameter 6" inches.
- (2) Total Depth 246' feet.
- (3) Water Level 122' feet below top of ground.
- (4) Cased to 164', Size 4"
- (5) Screen: Size 2 1/2", Length 10'
- (6) Were any formations sealed against pollution?  
 yes,  no.

If YES depth of formation 4' from surface,

Why To prevent surface pollution

Drillers Remarks:

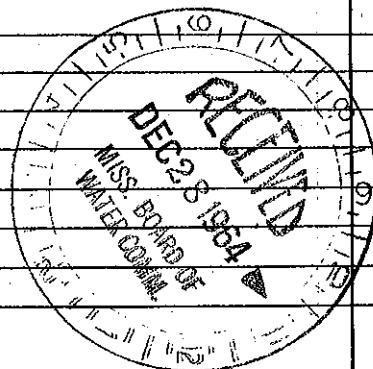

(Use Back Side)

Well No.