

COPIAH MISSISSIPPI BOARD OF WATER COMMISSIONERS



6-27-61

WATER WELL DRILLERS LOG

Date: June 27, 19 61, Driller: Burney Water Well Serv. County Copiah

(Name)

	Description & Color of Materials Sand, Clay, Red Clay, Shell, etc.	Thick- ness Feet	Depth Feet
(1) Owner of Land: <u>J. W. (Edd) Johnson</u> (Name)	Topsoil & clay	8	8
<u>Crystal Springs, Miss.</u> (Address)	Red sand & gravel	63	71
(2) Location: <u>Harmony Road</u> <u>1/4, 1/4, Sec. T. R.</u>	Sand	5	76
<u>6 miles East</u> , of <u>Crystal Springs</u> (distance) (direction) (Nearest Town)	Clay gravel	14	90
(3) Topography: <u>Hilly</u> (Hilly) (Flat) (Level)	Sand	6	96
(4) Purpose of Well: <u>Domestic</u> (Domestic Irrigation, Municipal, Industrial, Other)	Pipe clay & clay gravel	43	139
	Water Sand	8	147


Information upon completion of well:

- (1) Diameter 4 inches.
- (2) Total Depth 146 feet.
- (3) Water Level 113' feet below top of ground.
- (4) Cased to 137', Size 2"
- (5) Screen: Size 2", Length 5'
- (6) Were any formations sealed against pollution?
X yes, _____ no.

If YES depth of formation From surface

Why To prevent surface pollution

Drillers Remarks:

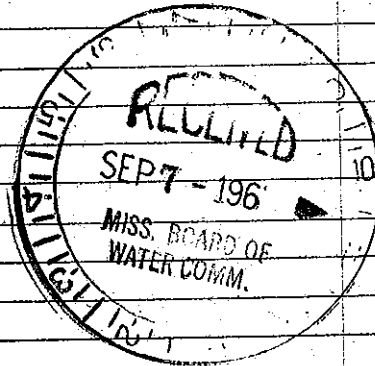

(Use Back Side)

Well No.