


COPIAH MISSISSIPPI BOARD OF WATER COMMISSIONERS

0 2000
9-3-64

WATER WELL DRILLERS LOG

Date: Sept. 3, , 19 64 , Driller: Burney Water Well Serv County Copiah
(Name)

	Description & Color of Materials Sand, Clay, Red Clay, Shell, etc.	Thick- ness Feet	Depth Feet
(1) Owner of Land: <u>Dan Scurlock</u> (Name)	Red top soil	8	8
<u>Rt. 2, Box 62, Hazlehurst, Miss</u> (Address)	Sand & gravel	22	30
Centerpoint Community	All red sand	30	60
(2) Location: <u>1/4, 1/4, Sec. 1, T. 1 N.</u> <u>Highway 28</u>	Sand & pipe clay	29	89
<u>7</u> miles <u>West</u> of <u>Hazlehurst</u> (distance) (direction) (Nearest Town)	Rock	1	90
(3) Topography: <u>Hilly</u> (Hilly) (Flat) (Level)	Pea gravel	6	96
(4) Purpose of Well: <u>Domestic</u> (Domestic Irrigation Municipal, Industrial, Other)	Cavern	6	102
Information upon completion of well:			
(1) Diameter <u>4</u> inches.			
(2) Total Depth <u>102</u> feet.			
(3) Water Level <u>62</u> feet below top of ground.			
(4) Cased to <u>92'</u> , Size <u>4"</u>			
(5) Screen: Size <u>2 1/8"</u> , Length <u>5'</u>			
(6) Were any formations sealed against pollution?			
<u>X</u> yes, <u> </u> no.			
If YES depth of formation <u>from surface</u>			
Why <u>to prevent surface pollution</u>			
Drillers Remarks: <u>well seal used</u>			

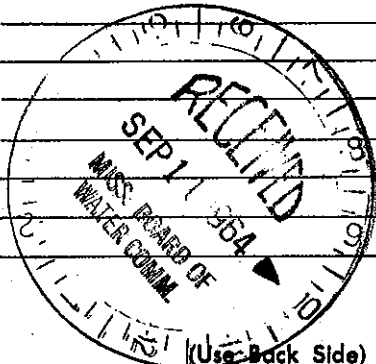

Well No.