

COPIAH MISSISSIPPI BOARD OF WATER COMMISSIONERS

PEX 34  
3-64

WATER WELL DRILLERS LOG

**CODED**

Date: March 1964, Driller: Carlross Well Supply County Coptah

(Name)

(1) Owner of Land: City of Hazlehurst  
(Name)

Hazlehurst, Mississippi

(Address)

Faller Street Well #7

(2) Location: 1/4, 1/4 Sec. 7 T. 10R 2

miles

of

(distance)

(direction)

(Nearest Town)

(3) Topography:

(Hilly)

(Flat)

(Level)

(4) Purpose of Well:

Municipal

(Domestic Irrigation)

(Municipal/Industrial/Other)

Information upon completion of well:

(1) Diameter 20 inches.

(2) Total Depth 443'-7" feet.

(3) Water Level 160 feet below top of ground.

(4) Cased to 375'-11" Size 20" O.D.

(5) Screen: Size 10" Length 54"

(6) Were any formations sealed against pollution?

yes,  no.


If YES depth of formation Casing Cemented

Why

Drillers Remarks:

Description & Color of Materials Sand, Clay, Red Clay, Shell, etc.	Thickness Feet	Depth Feet
Top Soil	10'	10'
Hard Clay	20'	30'
Blue Shale	60'	90'
Hard Blue Shale	63'	153'
Fine Grey Sand	26'	179'
Hard Blue Shale	8'	187'
Fine Grey Sand	13'	200'
Hard Blue Shale	11'	211'
Fine Grey Sand	5'	216'
Sandy Shale	4'	220'
Hard Blue Shale	2'	262'
Fine Grey Sand	22'	284'
Sand & Blue Shale	4'	288'
Blue Shale	3'	291'
Fine Grey Sand	25'	316'
Blue Shale	2'	318'
Sand and Shale	8'	326'
Hard Grey Shale	40'	366'
Hard Shale	9'	375'
Dark Grey W.B. Sand	66'	441'
Hard Grey Shale	8'	449'

**CODED**

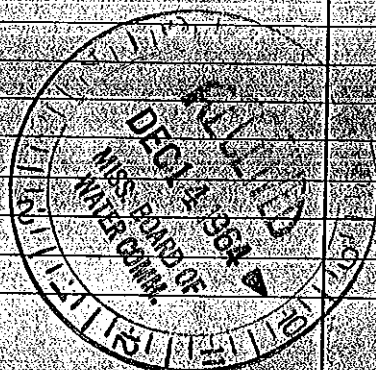

(Use Back Side)

Well No.

Mail this copy to Board of Water Commissioners 429 Miss. St. Jackson, Miss.