

COPIAH MISSISSIPPI BOARD OF WATER COMMISSIONERS

P 51

P 51

CODED 300

11-30-60

WATER WELL DRILLERS LOG

Copiah

Date Nov 30, 1960 Driller E. R. Jones County Copiah

(Name)

(1) Owner of Land J. A. Sandifer
(Name)

Rt. 4 Wesson
(Address)

(2) Location: $\frac{32}{4}$ $\frac{33}{10}$ $\frac{85}{20}$
4 miles South of Hazelhurst
(distance) (direction) (Nearest Town)

(3) Topography: Hilly
(Hilly) (Flat) (Level)

(4) Purpose of Well: Domestic
(Domestic Irrigation, Municipal, Industrial, Other)

Description & Color of Materials Sand, Clay, Red Clay, Shell, etc.	Thick- ness Feet	Depth Feet
Brown Clay	0	10
Grey & Red Clay	10	20
Grey Clay	20	35
Brown & Red Clay	35	36
Brown Clay	36	45
Blue Clay Sand Stream	45	57
Sand	57	53
Blue Clay	53	145
Sand	145	151
Blue Clay with Sand Stream	151	160
Blue Clay	160	176
Sand	176	180
Blue Clay Sand Stream	180	190
Brown Clay	190	200
Soft Blue Clay	200	206
Sand rock with Sand Stream	206	212
Blue Clay	212	230

Information upon completion of well:

(1) Diameter 6 1/2 inches.

(2) Total Depth 230 feet.

(3) Water Level 145 feet below top of ground.

(4) Cased to 220' Size 4"


(5) Screen Size _____ Length _____

(6) Were any formations sealed against pollution?
yes no

If YES depth of formation _____

Why _____

Drillers Remarks _____

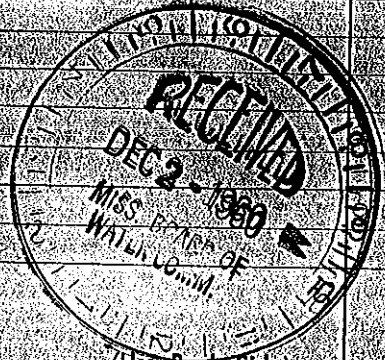

(Use Back Side)

Well No.

Mail this copy to Board of Water Commissioners 429 Miss. St. Jackson, Miss.