

MISSISSIPPI
BOARD OF WATER COMMISSIONERS
416 North State Street
Jackson, Mississippi 39201

WATER WELL DRILLERS LOG

Copiah
Q P 58
10-67
Elec Log
10-5

CODED
MCS


1967 Super Control Co. firm name
Copiah county well located

LANDOWNER: City of
Hazlehurst
Hazlehurst, Miss
(mailing address)
WELL LOCATION: Marly property
12-10 N
sec. 14 T-10 R-9 E
3 miles E of Hazlehurst
(distance) (direction) (nearest town)

description of formations encountered	from	to
<u>Top Soil</u>	<u>0</u>	<u>1</u>
<u>Red Clay</u>	<u>1</u>	<u>18</u>
<u>Clay & Sand</u>	<u>18</u>	<u>28</u>
<u>Hard Clay</u>	<u>28</u>	<u>88</u>
<u>Soft Clay</u>	<u>88</u>	<u>118</u>
<u>Hard Clay</u>	<u>118</u>	<u>160</u>
<u>Shale & Sand Strands</u>	<u>160</u>	<u>183</u>
<u>Sand</u>	<u>183</u>	<u>198</u>
<u>Clay</u>	<u>198</u>	<u>285</u>
<u>Sand, Coarse</u>	<u>285</u>	<u>358</u>
<u>Clay</u>	<u>358</u>	<u>362</u>

WELL PURPOSE: Municipal
(home, irrigation, municipal, industrial)

WELL COMPLETION DATA:
(1) diameter (inches) 18"
(2) total depth (feet) 360'
(3) static water level (feet) 120 below above top of ground.
(4) casing Steel 290
(material) (depth)
18" if telescope see back.
(size)
(5) screen 60' 295'
(length) (depth to top)
12" Stainless Steel
(size) (material)
(6) pump _____ (HP) _____ (yield gpm)
Electric
(type power)
(7) electric log yes
(yes or no)
Schlumberger
(organization running log)
(8) how well bottom plugged Solid
Bottom

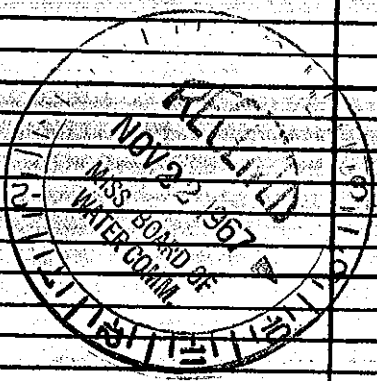

DRILLERS REMARKS:
Test not run as of
this date