

COPIAH MISSISSIPPI BOARD OF WATER COMMISSIONERS

P 60
2-13-64

MS-EW-08106
WATER WELL DRILLERS LOG

Arden

Date: 2-13-1964 Driller: Layne-Central Co. County Copiah

(Name)		Description & Color of Materials Sand, Clay, Red Clay, Shell, etc.	Thick- ness Feet	Depth Feet
(1) Owner of Land: City of Hazlehurst		top soil	1	1
(Address) Hazlehurst, Mississippi		sandy clay	9	10
(2) Location: 1/4, 3/4, Sec. 10N R2W T 18S		coarse gravel-clay stks	44	54
(distance) miles (direction) of (Nearest Town)		clay	21	75
(3) Topography: (Hilly) (Flat) (Level)		hard blue clay	30	105
(4) Purpose of Well: Municipal		brittle clay-hd&st. stks	64	169
(Domestic Irrigation Municipal, Industrial, Other)		clay-stks sand	20	189
		clay	53	242
		sand	30	272
		clay	2	274
		sand	17	291


Information upon completion of well:

- (1) Diameter 18 inches.
- (2) Total Depth 291 feet.
- (3) Water Level 233 feet below top of ground.
- (4) Cased to 241', Size 18"
- (5) Screen: Size 10", Length 26' 3"
- (6) Were any formations sealed against pollution?
 yes, no.

If YES depth of formation 241'

Why required

Drillers Remarks:

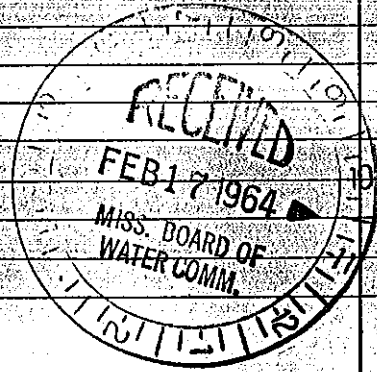

(Use Back Side)

Well No.

Mail this copy to Board of Water Commissioners 429 Miss. St. Jackson, Miss