

COPIAH MISSISSIPPI BOARD OF WATER COMMISSIONERS

P 7002
6-26-64

WATER WELL DRILLERS LOG

Date: June 26, 1964, Driller: Burney Water Well Serv County: Copiah

(Name)

(1) Owner of Land: James Taylor
(Name)

Route 4, Hazlehurst, Mississippi

(Address)
Dentyville Road

(2) Location: 1/4, 1/4, Sec. 10 2 W

3 miles west of Hazlehurst
(distance) (direction) (Nearest Town)

(3) Topography: Hilly
(Hilly) (Flat) (Level)

(4) Purpose of Well: Domestic
(Domestic Irrigation
Municipal, Industrial, Other)

| Description & Color of Materials Sand, Clay, Red Clay, Shell, etc. | Thick- ness Feet | Depth Feet |
|---|------------------------|---------------|
| Top soil and red clay | 4 | 4 |
| Gravel and sand | 18 | 22 |
| Big gravel | 19 | 41 |
| Sand stone | 1 | 42 |
| Pipe clay | 18 | 60 |
| Fine sand layers | 3 | 63 |
| Blue & grey clay | 79 | 142 |
| Tight hard fine sand | 18 | 160 |
| Shale & fine sand | 22 | 182 |


Information upon completion of well:

- (1) Diameter 4 1/2 inches.
- (2) Total Depth 182 feet.
- (3) Water Level 129 feet below top of ground.
- (4) Cased to 148 1/2, Size 2"
- (5) Screen: Size 2 1/2, Length 5'
- (6) Were any formations sealed against pollution?
X yes, no.

If YES depth of formation 4' from surface

Why To prevent surface pollution

Drillers Remarks:

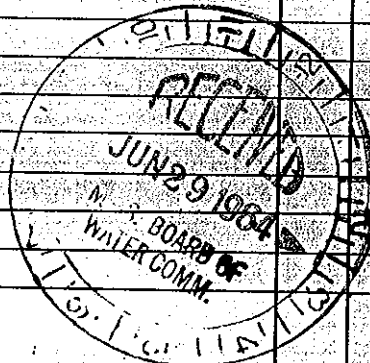

(Use Back Side)

Well No.

Mail this copy to Board of Water Commissioners 429 Miss. St. Jackson, Miss.