

COPIAH

MISSISSIPPI BOARD OF WATER COMMISSIONERS

1-9-63

WATER WELL DRILLERS LOG

Date: 1/9/1963 Driller: Ray's Pump & Iron Works, Copiah, Miss. (Ray & Charles) (Name)

(1) Owner of Land: Mr. Ashley
 (Name)
 1/2 Ashley Super Market
 (Address)
 W. Dixon, Miss.
 (2) Location: 1/4 Sec. 13, T. 9N, R. 9E
 9 miles NE of Wesson
 (distance) (direction) (Nearest Town)
 (3) Topography: (Hills) (Flat) (Level)
 (4) Purpose of Well: house & DAIRY BARN
 (Domestic, Irrigation, Municipal, Industrial, Other)

Description & Color of Materials Sand, Clay, Red Clay, Shell, etc.	Thickness Feet	Depth Feet
yellow clay	4	TOP
green brown pipe clay only		
after passing thru water sand -		
36 steel Caisson		

Information upon completion of well:

(1) Diameter: 24 inches ID

(2) Total Depth: 70' feet

(3) Water Level: 30' (feet) below top of ground

(4) Cased to: 60' size 24" ID


(5) Screen Size: NONE length

(6) Were any formations sealed against pollution?
 LARGE CEMENT TILES
 yes no
 OWNER WILL FINISH SEALING
 If YES depth of formation

used to temporarily seal off water to complete reservoir and set tiles

Steel Caisson removed after setting tiles -

Why:
 Drillers Remarks: Hard green clay only - found past top water sand

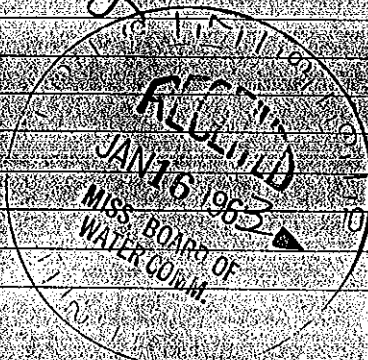

Well No

(Use Back Side)