

Gw 08208

MISSISSIPPI
BOARD OF WATER COMMISSIONERS
416 North State Street
Jackson, Mississippi 39201

Q 11
M 08


WATER WELL DRILLERS LOG

Copiah
Q 11
11-07
Elec Log

11-17-1967 date well completed
Layne Central Co. firm name
Copiah county well located

LANDOWNER:	description of formations encountered	from	to
City of Hazlehurst	Clay	0	21
Hazlehurst, Miss (mailing address)	Sand & Gravel	21	38
	Clay	38	148
WELL LOCATION: George Marx property	Hard Shale	148	200
sec. 7 T 10 N R 9 E	Extra Hard Shale	200	225
3 miles E of Hazlehurst (distance) (direction) (nearest town)	Sandy Shale	225	271
	Sand & Shale streaks	271	281
	Sand	281	313
WELL PURPOSE: Municipal (home, irrigation, municipal, industrial)	Sand	313	336
	Sand	336	341
WELL COMPLETION DATA:	Gravel Sand	341	359
(1) diameter (inches) 18"	Sand & Shale	359	365
(2) total depth (feet) 351'	Hard Shale	365	369
(3) static water level (feet) 134 below top of ground.			
(4) casing Steel 280 (material) (depth) 18" (size) if telescope see back.			
(5) screen 60' 286' (length) (depth to top) 12" Stainless Steel (size) (material)			
(6) pump Electric (HP) (yield gpm) (type power)			
(7) electric log Yes (yes or no) Schlumberger (organization running log)			
(8) how well bottom plugged Solid Bottom			

CODED

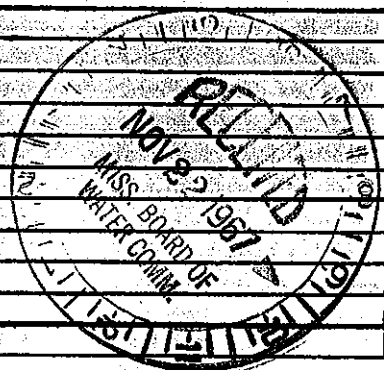

DRILLERS REMARKS:
Test not run as of this date.