

COPAH  
Q18  
7-22-65

MISSISSIPPI BOARD OF WATER COMMISSIONERS

**CODED**

**WATER WELL DRILLERS LOG**

Date: 7-22, 1965, Driller: Forest Drilling County: COPAH  
(Name)


(1) Owner of Land: Norma Keys  
(Name)  
Rt 1 Box 244  
(Address)  
Crystal Springs 100 MW  
(2) Location: 1/4, 1/4, Sec. 8 T R  
Greenville com. of E. Springs  
(distance) (direction) (Nearest Town)  
(3) Topography: \_\_\_\_\_  
(Hilly) (Flat) (Level)  
(4) Purpose of Well: Home  
(Domestic Irrigation  
Municipal, Industrial, Other)

Description & Color of Materials Sand, Clay, Red Clay, Shell, etc.	Thick- ness Feet	Depth Feet
<u>Hard Clay</u>		<u>20</u>
<u>Light Rock &amp; Brk Ch</u>		<u>30</u>
<u>Light Rock &amp; Clay</u>		<u>61</u>
<u>Light &amp; Clay</u>		<u>123</u>
<u>Blue Clay</u>		<u>163</u>
<u>Shale</u>		<u>177</u>
<u>fine Sand &amp; Shs Shale</u>		<u>190</u>
<u>Hard &amp; Rock</u>		<u>199</u>
<u>Sand</u>		<u>199</u>

Information upon completion of well:

(1) Diameter 2 inches.  
(2) Total Depth 199 feet.  
(3) Water Level 94 feet below top of ground.  
(4) Cased to 189, Size 2"  
(5) Screen: Size 2", Length 10ft  
(6) Were any formations sealed against pollution?  
\_\_\_\_\_ yes,  no.  
If YES depth of formation \_\_\_\_\_  
Why \_\_\_\_\_  
Drillers Remarks: \_\_\_\_\_

**CODED**

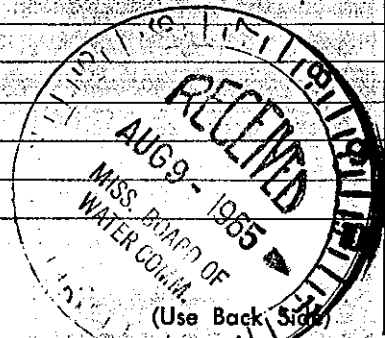

Well No.

Mail this copy to Board of Water Commissioners 429 Miss. St. Jackson, Miss.