STATE WELL REPORT Well No	
Part 1 For Office U	
Driller's Log Well #:	33
Aquifer:	
Aquifer:	
ate drilling completed: 7/1/16 Jackson, MS 39225-2309	
(601)961-5210 (601)360-0535 (fax)	
State Law requires that this report be prepared by the license holder responsible for the work and filed	with the
Department at the above address within 30 days of completion of drilling of the well or borenoie.	
Well Owner Information Well or Borehole Location	i ir ,
(Landowner if borehole is not for a water well) Latitude: <u>31°47 13 N</u> Longitude: <u>90°17</u>	4 W_
Dwner Name: Joy McCardle Method of Lat/Long (check one): Conventional S	urvey,
hilling Address: (117 Mc Canalle KOL.	
USGS quad, Hand-held GPS, Survey-gr	
Hazlehurst MS 39083 310 45E 4, sec 34 TION	
City State Zip Code S Miles SE of Hazlehu	irst
Felephone No. (601) 894-4053 (Distance) (Direction) (Nearest	Town)
Well / Borehole Data Date drilling started: <u>630/16</u> Date drilling completed: <u>7/1/16</u> Hole depth: <u>145</u> Hole diamete	er: <u>4</u> "
Location of the source of any surface water used for drilling:	
Method of dosing and volume of Chlorine used in drilling and development:	
Logs run (circle all applicable): No log run Electric Gamma Ray Density Sonic Neutron Other:	
Name of organization running log(s):	
Purpose of borehole (circle one) Water Well Geotechnical/Geological Investigation Ground Source He	at Pump
Seismic Survey Other (describe)	
If drilling is not related to water well construction, skip the remainder of this block	
Purpose of Well (circle all applicable): Home Industrial Public Supply Irrigation Fish Culture	
Other (describe): Chidten Farm	
If a flowing well, method of flow regulation: Valve Other (describe)	
If a flowing well, method of flow regulation. Valve Other (debility)	
Method of measurement (circle one): Steel tape Electric tape Air line Other (describe):	
Method of measurement (<i>circle one</i>): Steel tape Electric tape Air line Other (<i>describe</i>): Well depth: <u>145</u> Well grouted to a depth of: <u>50</u> feet Type of grout (<i>circle one</i>): Neat Cement B	Sentonite Mix
Method of measurement (<i>circle one</i>): Steel tape Electric tape Air line Other (<i>describe</i>): Well depth: <u>145</u> Well grouted to a depth of: <u>50</u> feet Type of grout (<i>circle one</i>) Neat Cement B Casing length: <u>115</u> feet Casing diameter: <u>4</u> inches Type of casing: <u>ρ</u>	Sentonite Mix
Method of measurement (circle one): Steel tape Electric tape Air line Other (describe): Well depth: <u>145</u> Well grouted to a depth of: <u>50</u> feet Type of grout (circle one): Neat Cement B Casing length: <u>115</u> feet Casing diameter: <u>4</u> inches Type of casing: <u>P<</u> Screen length: <u>30</u> feet Screen diameter: <u>4</u> inches Type of screen: <u>P<</u>	Sentonite Mix
Method of measurement (circle one): Steel tape Electric tape Air line Other (describe):	Sentonite Mix
Method of measurement (<i>circle one</i>): Steel tape Electric tape Air line Other (<i>describe</i>): Well depth: <u>145</u> Well grouted to a depth of: <u>50</u> feet Type of grout (<i>circle one</i>) Neat Cement B Casing length: <u>115</u> feet Casing diameter: <u>4</u> inches Type of casing: <u>ρ were structure</u> Screen length: <u>30</u> feet Screen diameter: <u>4</u> inches Type of screen: <u>ρ were structure</u>	Sentonite Mix / / C feet lopment
Method of measurement (circle one): Steel tape Electric tape Air line Other (describe):	Bentonite Mix / / C feet
Well depth: <u>145</u> Well grouted to a depth of: <u>50</u> feet Type of grout (<i>circle one</i>). Neat Cement B Casing length: <u>115</u> feet Casing diameter: <u>4</u> inches Type of casing: <u>PV</u> Screen length: <u>30</u> feet Screen diameter: <u>4</u> inches Type of screen: <u>PV</u> Screen slot size: <u>010</u> inches Setting depth: From <u>115</u> feet to <u>145</u> Type of completion (<i>circle all applicable</i>): Gravel packed Underreamed Open hole Natural Devel	Sentonite Mix / / C feet lopment

• • • •

•#

County:	Copiah	
Permit #:		


Well No. 2 of L	f
For Office Use Only	
Well #	

The sketch below only required for water wells

If well telescopes, show depths on sketch.

K


Ground Level

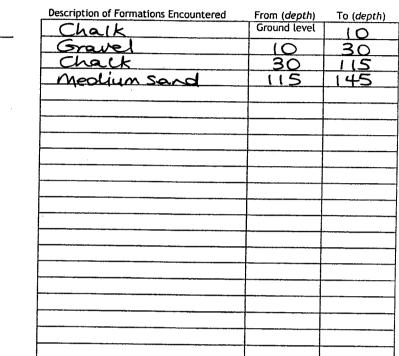

Description of formations encountered must be provided for all wells

and boreholes, unless specifically exempted by regulations

If more than one screen, show location of each on sketch

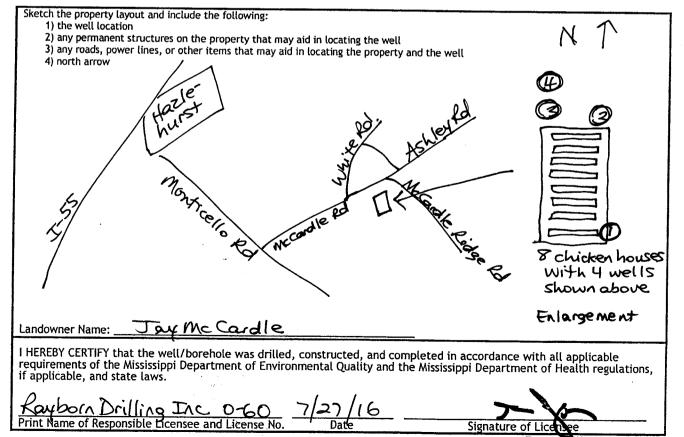

Form: OLWR-SWR-1A (4/13)

		STATE W	ELL REPORT	
			Part 2	Well No. 2074
County: <u>Copian</u> Permit #:	······	Pump Installe	er's Completion Report	For Office Use Only:
Driller: Gary Ray	haca	Mississippi Departr	nent of Environmental Quality	well #: 0 3.2
Date completed:		1	nd and Water Resources	
			on, MS 39225-2309	Aquifer:
Copy information from b		· ·	601)961-5210) 360-0535 (fax)	
			well contractor or a licensed pu	
	ner Informati			<i>within 30 days of well completion</i> . Location
	McCan	dle	Latitude: 31 41 13 1 Longitude: 90 17 4 W	
Mailing Address:		-		conventional Survey,
				PS, Survey-grade GPS
Haztehurst	MS	39083		34 TION R9E
		Zip Code	8 Miles SE	
Telephone No. (601)	894-40	<u>\$53</u>	(Distance) (Direction)	(Nearest Town)
	· · · · · ·	Pump Tvr	pe (circle one)	· · · · · · · · · · · · · · · · · · ·
Submersible Turbine Ai	ir Lift Centrif	ugal Flowing Well	Jet Piston Rotary Other (de	escribe):
	1 1			Gallons Per Minute
				outons i er mindee
s This Pump (circle one):	(New) Rej		pe (circle one)	
Flectric Diesel Gasoline	 Natural Gas 	•	dmill Other (<i>describe</i>):	
\smile	<u> </u>		-	(
Horse Power Rating of Mo			h In feet Number	of Stages: 14
Horse Power Rating of Mo			h: <u>136</u> feet Number	of Stages:
		Pump Test Data	for Non Flowing Well	
Date Well Tested:7	11/16	Pump Test Data	for Non Flowing Well Duration of Pump Test (<i>minin</i>	num 4 hours); hours
Static water Level (A):	1 1 6 8 8 Fee	Pump Test Data	for Non Flowing Well Duration of Pump Test (<i>minin</i> Pumping Water Level (B):	num 4 hours); hours
Date Well Tested: Static Water Level (A):	1 1 6 8 8 Fee	Pump Test Data	for Non Flowing Well Duration of Pump Test (<i>minin</i> Pumping Water Level (B):	num 4 hours); hours
Date Well Tested: Static Water Level (A): Drawdown [(B) - (A)]:	6 88_ Fee	Pump Test Data t Below Land Surface Feet Below Land Surf	for Non Flowing Well Duration of Pump Test (<i>minin</i> Pumping Water Level (B): face Test Pumping Rate:	num 4 hours); hours
Date Well Tested: Static Water Level (A): Drawdown [(B) - (A)]:	6 88_ Fee	Pump Test Data t Below Land Surface Feet Below Land Surf ceel tape Electric ta	for Non Flowing Well Duration of Pump Test (<i>minin</i> Pumping Water Level (B): face Test Pumping Rate:	num 4 hours): hours Feet Below Land Surface Gallons Per Minute
Date Well Tested:7 Static Water Level (A): Drawdown [(B) - (A)]: Wethod of measurement (Measured shut in head:	(circle one): St	Pump Test Data t Below Land Surface Feet Below Land Surf ceel tape Electric ta Pump Test Dat	for Non Flowing Well Duration of Pump Test (<i>minin</i> Pumping Water Level (B): _ face Test Pumping Rate: ape Air line Other (<i>describe</i>): _ ta for Flowing Well	num 4 hours): hours Feet Below Land Surface Gallons Per Minute
Date Well Tested:7 Static Water Level (A): Drawdown [(B) - (A)]: Wethod of measurement (Measured shut in head:	(circle one): St	Pump Test Data t Below Land Surface Feet Below Land Surf ceel tape Electric ta Pump Test Dat	for Non Flowing Well Duration of Pump Test (<i>minin</i> Pumping Water Level (B): Face Test Pumping Rate: Ape Air line Other (<i>describe</i>):	num 4 hours): hours Feet Below Land Surface Gallons Per Minute
Date Well Tested:7 Static Water Level (A): Drawdown [(B) - (A)]: Method of measurement (Measured shut in head:	(circle one): St	Pump Test Data t Below Land Surface Feet Below Land Surf ceel tape Electric ta Pump Test Dat drawdown of	for Non Flowing Well Duration of Pump Test (<i>minin</i> Pumping Water Level (B): _ face Test Pumping Rate: ape Air line Other (<i>describe</i>): _ ta for Flowing Well	num 4 hours): hours Feet Below Land Surface Gallons Per Minute
Date Well Tested: Static Water Level (A): Drawdown [(B) - (A)]: Method of measurement (Measured shut in head: Well yielded	(circle one): St	Pump Test Data t Below Land Surface Feet Below Land Surf teel tape Electric ta Pump Test Dat Irawdown of Meter	for Non Flowing Well Duration of Pump Test (minin Pumping Water Level (B): face Test Pumping Rate: ape Air line Other (describe): ta for Flowing Well feet after Installation	num 4 hours): hours Feet Below Land Surface Gallons Per Minute
Date Well Tested:7 Static Water Level (A): Drawdown [(B) - (A)]: Method of measurement (Measured shut in head: Well yielded Meter Manufacturer:	(circle one): Si feet feet	Pump Test Data t Below Land Surface Feet Below Land Surf teel tape Electric ta Pump Test Dat Irawdown of Meter	for Non Flowing Well Duration of Pump Test (minin Pumping Water Level (B): face Test Pumping Rate: ape Air line Other (describe): ta for Flowing Wellfeet after InstallationMeter Serial Number:	num 4 hours); hours Feet Below Land Surface Gallons Per Minute
Date Well Tested:7 Static Water Level (A): Drawdown [(B) - (A)]: Method of measurement (Measured shut in head: Well yielded Weter Manufacturer: Meter Model Number/Nar	(circle one): St feet feet GPM with a c	Pump Test Data t Below Land Surface Feet Below Land Surf ceel tape Electric ta Pump Test Dat drawdown of Meter	for Non Flowing Well Duration of Pump Test (minin Pumping Water Level (B): face Test Pumping Rate: ape Air line Other (describe): ta for Flowing Wellfeet after InstallationMeter Serial Number: Type of Meter:	hours): hours Feet Below Land Surface Gallons Per Minute
Date Well Tested: Static Water Level (A): Drawdown [(B) - (A)]: Method of measurement (Measured shut in head: Well yielded Meter Manufacturer: Meter Model Number/Nar Totalizer Register Unit ar	(circle one): St (circle one): St (circl	Pump Test Data t Below Land Surface Feet Below Land Surf ceel tape Electric ta Pump Test Dat Irawdown of Meter I Actor (AF x .001, gal	for Non Flowing Well Duration of Pump Test (minin Pumping Water Level (B): face Test Pumping Rate: ape Air line Other (describe): ta for Flowing Well feet after feet after Installation Type of Meter: X 1000, etc):	num 4 hours): hours Feet Below Land Surface Gallons Per Minute
Date Well Tested:7 Static Water Level (A): Drawdown [(B) - (A)]: Method of measurement (Measured shut in head: Well yielded Weter Manufacturer: Meter Manufacturer: Meter Model Number/Nar Totalizer Register Unit an Installation Date:	(circle one): St (circle one): St feet GPM with a c	Pump Test Data t Below Land Surface Feet Below Land Surf ceel tape Electric ta Pump Test Dat	for Non Flowing Well Duration of Pump Test (minin Pumping Water Level (B): face Test Pumping Rate: ape Air line Other (describe): ta for Flowing Wellfeet after feet after Installation Meter Serial Number: X 1000, etc):	num 4 hours); hours Feet Below Land Surface Gallons Per Minute
Date Well Tested:7 Static Water Level (A): Drawdown [(B) - (A)]: Wethod of measurement (Measured shut in head: Weter Manufacturer: Weter Manufacturer: Meter Model Number/Nar Totalizer Register Unit ar Installation Date: Is This Meter (circle one):	(circle one): St (circle one): St feet 	Pump Test Data t Below Land Surface Feet Below Land Surf ceel tape Electric ta Pump Test Data	for Non Flowing Well Duration of Pump Test (minin Pumping Water Level (B): face Test Pumping Rate: ape Air line Other (describe): ta for Flowing Wellfeet after feet after Installation Meter Serial Number: X 1000, etc):	num 4 hours): hours Feet Below Land Surface Gallons Per Minute hours of pumping
Date Well Tested:7 Static Water Level (A): Drawdown [(B) - (A)]: Method of measurement (Measured shut in head: Well yielded Weter Manufacturer: Meter Model Number/Nar Totalizer Register Unit ar Installation Date: Is This Meter (circle one):	(circle one): St (circle one): St (circl	Pump Test Data t Below Land Surface Feet Below Land Surf ceel tape Electric ta Pump Test Dat	for Non Flowing Well Duration of Pump Test (minin Pumping Water Level (B): face Test Pumping Rate: ape Air line Other (describe): ta for Flowing Wellfeet after feet after InstallationMeter Serial Number: Type of Meter: x 1000, etc): ent ertifying that this meter was instal proved meters is on the MDEQ w	num 4 hours): hours Feet Below Land Surface Gallons Per Minute hours of pumping

By	O	W	R
шy	$\mathbf{\nabla}$	A A	11