

**COPIAH MISSISSIPPI BOARD OF WATER COMMISSIONERS**

2001  
5-5-64


**WATER WELL DRILLERS LOG**

Date: May 5, 1964, Driller: Burney Water Well Ser County Copiah

(Name)

(1) Owner of land: J. W. McCardle  
(Name)  
Route 3, Wesson, Miss.  
(Address)  
Rockport Road  
(2) Location: 1/4, 1/4 Sec. 10, 9E  
1 1/2 miles S W of Rockport  
(distance) (direction) (Nearest Town)  
(3) Topography: Level  
(Hilly) (Flat) (Level)  
(4) Purpose of Well: Domestic  
(Domestic Irrigation  
Municipal, Industrial, Other)

Description & Color of Materials Sand, Clay, Red Clay, Shell, etc.	Thick- ness Feet	Depth Feet
Red top soil	6	6
Yellow & gray pipe clay	18	24
Hard blue clay	19	43
Gray tight clay	30	73
Layers fine sand	3	76
Shale	9	85
Fine sand	5	90
All sand but fine	10	100

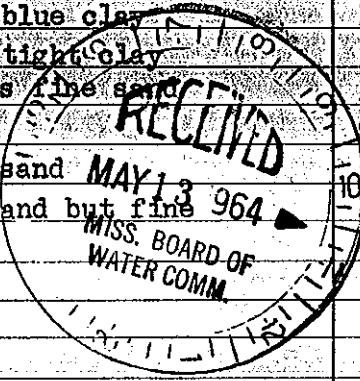

Information upon completion of well:

(1) Diameter 6 inches.  
(2) Total Depth 101 feet.  
(3) Water Level 32 feet below top of ground.  
(4) Cased to 89' Size 4"  
(5) Screen: Size 2 1/2" Length 10'  
(6) Were any formations sealed against pollution?  
X yes,        no.

If YES depth of formation yes

Why to prevent surface pollution

Drillers Remarks: used sanitary well seal

Well No.

(Use Back Side)

Mail this copy to Board of Water Commissioners 429 Miss. St. Jackson, Miss.