

**COPIAH MISSISSIPPI BOARD OF WATER COMMISSIONERS**

~~3-27-62~~ **3-27-62 WATER WELL DRILLERS LOG**

Date: Mar. 27, 19 62 Driller: Burney Water Well Serv County Copiah

(Name)

(1) Owner of land: Mrs. Sadye Beazley

(Name)

Crystal Springs, Miss.

(Address)

Old Hwy 51 W 1/4 Sec 2 T. 10. 10 R.

(2) Location: \_\_\_\_\_

4 miles North of Crystal Springs

(distance)

(direction)

(Nearest Town)

(3) Topography: Hilly

(Hilly)

(Flat)

(Level)

(4) Purpose of Well: Domestic

(Domestic Irrigation  
Municipal; Industrial; Other)

Information upon completion of well:

(1) Diameter: 4 inches.

(2) Total Depth: 280 feet.

(3) Water Level: 131 feet below top of ground.

(4) Cased to: 250' Size: 2"

(5) Screen: Size: 2" Length: 5'

(6) Were any formations sealed against pollution?

yes,  no.

If YES: depth of formation: From surface

Why: To prevent surface pollution


Drillers Remarks: \_\_\_\_\_

Description & Color of Materials  
Sand, Clay, Red Clay, Shell, etc.

Thick-  
ness  
Feet

Depth  
Feet

<u>Red clay</u>	<u>4</u>	<u>4</u>
<u>Sand &amp; gravel</u>	<u>11</u>	<u>11</u>
<u>Blue &amp; grey clay</u>	<u>5</u>	<u>18</u>
<u>Sand &amp; iron rock</u>	<u>6</u>	<u>24</u>
<u>Hard grey shale</u>	<u>4</u>	<u>28</u>
<u>Clay &amp; sand layers</u>	<u>27</u>	<u>55</u>
<u>Fine sand</u>	<u>8</u>	<u>63</u>
<u>Blue clay</u>	<u>19</u>	<u>82</u>
<u>Brown Formation</u>	<u>18</u>	<u>100</u>
<u>Layers blue clay &amp; sand</u>	<u>116</u>	<u>216</u>
<u>Rock, Limest., shale</u>	<u>8</u>	<u>224</u>
<u>Fine sand layers</u>	<u>6</u>	<u>230</u>
<u>Hard limestone</u>	<u>19</u>	<u>249</u>
<u>Layers fine sand</u>	<u>7</u>	<u>256</u>
<u>Clay</u>	<u>6</u>	<u>262</u>
<u>Fine sand</u>	<u>3</u>	<u>265</u>
<u>Clay</u>	<u>15</u>	<u>280</u>

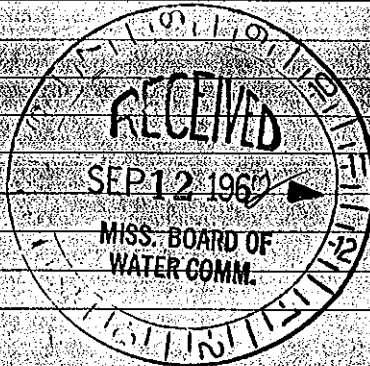

Well No.

(Use Back Side)

Mail this copy to Board of Water Commissioners 429 Miss. St. Jackson, Miss