

COPIAH
S10
4-5-73

MISSISSIPPI
 BOARD OF WATER COMMISSIONERS
 416 North State Street
 Jackson, Mississippi 39201

CODED

WATER WELL DRILLERS LOG

4-5 1973 Green Water Well Cont - Copiah
 date well completed firm name county well located

LANDOWNER:
J. R. McCurley
Post Season min
 (mailing address)

description of formations encountered	from	to
	<u>Ostracelle</u>	<u>0</u>

WELL LOCATION:
 sec 13 T 9 N R 5 E
18 miles W of Wesson
 (distance) (direction) (nearest town)

WELL PURPOSE: home
 (home, irrigation, municipal, industrial)

WELL COMPLETION DATA:

(1) diameter (inches) 6"

(2) total depth (feet) 84

(3) static water level (feet) 60 below/above top of ground.

(4) casing PVC, 68'
 (material) (depth)

(size) If telescope see back.

(5) screen 61, 68'
 (length) (depth to top)

.010, PVC
 (size) (material)

(6) pump did not install
 (HP) (yield gpm)

(type power)

(7) electric log no
 (yes or no)

(organization running log)

(8) how well bottom plugged Wood


DRILLERS REMARKS:

CODED

MAY 23 1973

If well telescopes please sketch and show depths.

GROUND LEVEL

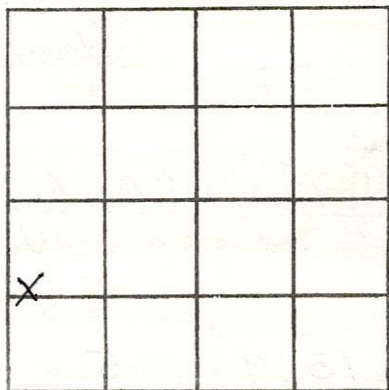

SECTION 13

Please indicate well location X.

ADDITIONAL INFORMATION

If more than one screen,
show locations of each on sketch.