

COPIA#
T3
7-3-62

MISSISSIPPI BOARD OF WATER COMMISSIONERS

WATER WELL DRILLERS LOG

OK'd
CODED

Date: 7/3/1962 Driller: W. J. Massey County: Copiah
(Name)

(1) Owner of Land	Description & Color of Materials Sand, Clay, Red Clay, Shell, etc.	Thick- ness Feet	Depth Feet
<u>The John S. Haythorn</u> (Name)			
<u>Rt. 2, 4, Hazlehurst, Miss.</u> (Address)	<u>Top soil and clay</u>	<u>0</u>	<u>2.0</u>
(2) Location: <u>1/4 Sec. 13 E</u>	<u>White Chalk</u>	<u>20</u>	<u>30</u>
<u>18 miles West of Hazlehurst</u> (distance) (direction) (Nearest Town)	<u>Blue Chalk</u>	<u>30</u>	<u>45</u>
(3) Topography: <u>Hilly</u> (Hilly) (Flat) (Level)	<u>White Chalk</u>	<u>45</u>	<u>60</u>
(4) Purpose of Well: <u>Domestic</u> (Domestic Irrigation Municipal, Industrial, Other)	<u>Dark white sand</u>	<u>60</u>	<u>105</u>
	<u>and fine gravel</u>	<u>105</u>	<u>126</u>

Information upon completion of well:


- (1) Diameter 4 inches.
- (2) Total Depth 126 feet.
- (3) Water Level 60 feet below top of ground.
- (4) Cased to 166, Size 4"
- (5) Screen: Size 2", Length 10 ft.
- (6) Were any formations sealed against pollution?
no.

If YES depth of formation _____

Why _____

Drillers Remarks: _____

CODED

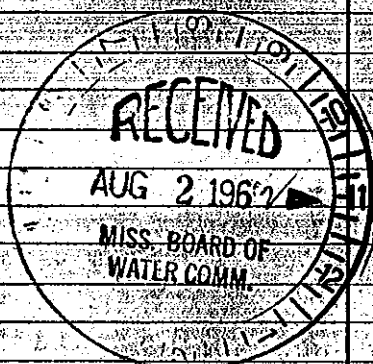

Well No.

(Use Back Side)

Mail this copy to Board of Water Commissioners 429 Miss. St. Jackson, Miss.