

COPIAH

MISSISSIPPI BOARD OF WATER COMMISSIONERS

T 4
5-9-66

WATER WELL DRILLERS LOG

OK for
CODED

Date: 5-9-1966 Driller: Alvin P. Pritchard County: Copiah
(Name)

(1) Owner of Land: J. C. Shannon
(Name)
Hogchust miss
(Address)

Description & Color of Materials Sand, Clay, Red Clay, Shell, etc.	Thick- ness Feet	Depth Feet
0 - 72 clay		
72 - 89 Red sand gravel		
89 - 157 white sand gravel		

(2) Location: 1/4 1/4 Sec 2 T 9 R 6
34 miles South of Hogchust
(distance) (direction) (Nearest Town)

(3) Topography: Level
(Hilly) (Flat) (Level)

(4) Purpose of Well: Home
(Domestic Irrigation
Municipal, Industrial, Other)

CODED

Information upon completion of well:

(1) Diameter 2 inches.

(2) Total Depth 157 feet.

(3) Water Level 122 feet below top of ground.

(4) Cased to 148 Size 2"


(5) Screen: Size 2" Length 3"

(6) Were any formations sealed against pollution?
no

If YES depth of formation

Why

Drillers Remarks:

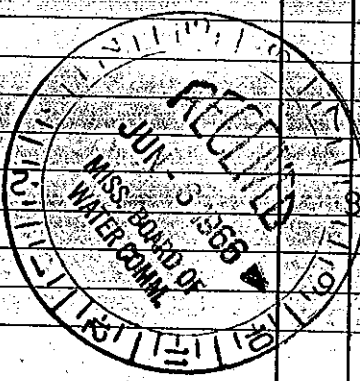

Well No.

(Use Back Side)

Mail this copy to Board of Water Commissioners 429 Miss. St. Jackson, Miss.