

STATE WELL REPORT

Part 1

Driller's Log

Mississippi Department of Environmental Quality
Office of Land and Water Resources
P.O. Box 2309
Jackson, MS 39225-2309
(601)961-5210
(601)360-0535 (fax)

County: Copiah
Permit #: _____
Driller: GREENN WATER WELL & SUPPLY, INC.
Date drilling completed: 1-29-14

For Office Use Only:

Well #: T 27
Aquifer: _____
E-Log #: _____

State Law requires that this report be prepared by the license holder responsible for the work and filed with the Department at the above address within 30 days of completion of drilling of the well or borehole.

Well Owner Information <small>(Landowner if borehole is not for a water well)</small>	Well or Borehole Location
Owner Name: <u>Ray Warren</u>	Latitude: <u>30° 44' 34"</u> Longitude: <u>90° 34' 50"</u>
Mailing Address: <u>3771 Alfred Loop</u>	Method of Lat/Long (check one): Conventional Survey _____, USGS quad _____, Hand-held GPS <input checked="" type="checkbox"/> , Survey-grade GPS _____
<u>Wesson MS 39191</u>	<u>SW 1/4 SW 1/4, Sec 14 T 9N R 6E</u>
City State Zip Code	<u>12</u> Miles <u>NW</u> of <u>WESSON</u>
Telephone No. <u>(601) 835-1235</u>	(Distance) (Direction) (Nearest Town)

Well / Borehole Data

Date drilling started: 1-29-14 Date drilling completed: 1-29-14 Hole depth: 335 Hole diameter: 8"

Location of the source of any surface water used for drilling: _____

Method of dosing and volume of Chlorine used in drilling and development: mudpie gravel pack

Logs run (circle all applicable): No log run Electric Gamma Ray Density Sonic Neutron Other: _____

Name of organization running log(s): _____

Purpose of borehole (circle one): Water Well Geotechnical/Geological Investigation Ground Source Heat Pump
 Seismic Survey Other (describe) _____

If drilling is not related to water well construction, skip the remainder of this block

Purpose of Well (circle all applicable): Home Industrial Public Supply Irrigation Fish Culture

Other (describe): Poultry Farm

If a flowing well, method of flow regulation: Valve _____ Other (describe) _____

Static Water Level: 127 feet [above or below] land surface Date measured: 1-29-14
(circle one)

Method of measurement (circle one): Steel tape Electric tape Airline Other (describe) _____

Well depth: 313 Well grouted to a depth of: 10 feet Type of grout (circle one): Neat Cement Bentonite Mix

Casing length: 273 feet Casing diameter: 4 inches Type of casing: PVC

Screen length: 40 feet Screen diameter: 4 inches Type of screen: PK

Screen slot size: .010 inches Setting depth: From 273 feet to 313 feet

Type of completion (circle all applicable): Gravel packed Underreamed Open hole Natural Development

Other (describe): _____

Top of lap pipe or reduction in casing: _____ feet


If telescoped or more than one screen, describe on next page

RECEIVED

County: Copiah
 Permit #: _____

For Office Use Only:
 Well #: _____


The sketch below only required for water wells
If well telescopes, show depths on sketch.

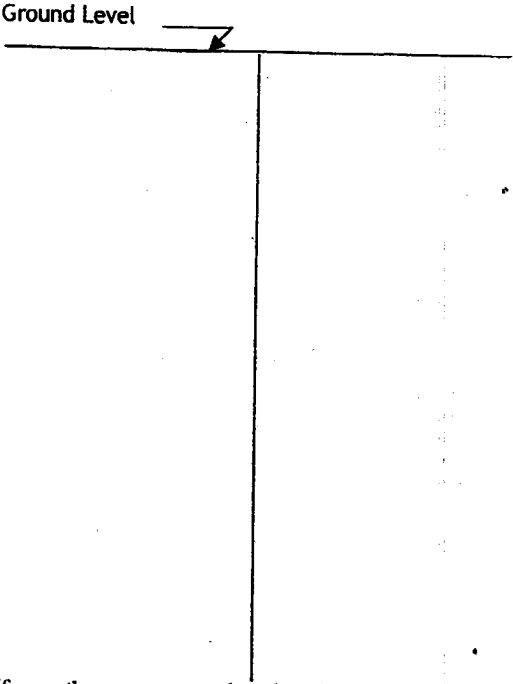

Description of formations encountered must be provided for all wells and boreholes, unless specifically exempted by regulations

Description of Formations Encountered	From (depth)	To (depth)
red clay	Ground level	29
gravel & sand	29	107
white clay	107	120
blue clay	120	220
sand	220	313
blue clay	313	335

If more than one screen, show location of each on sketch

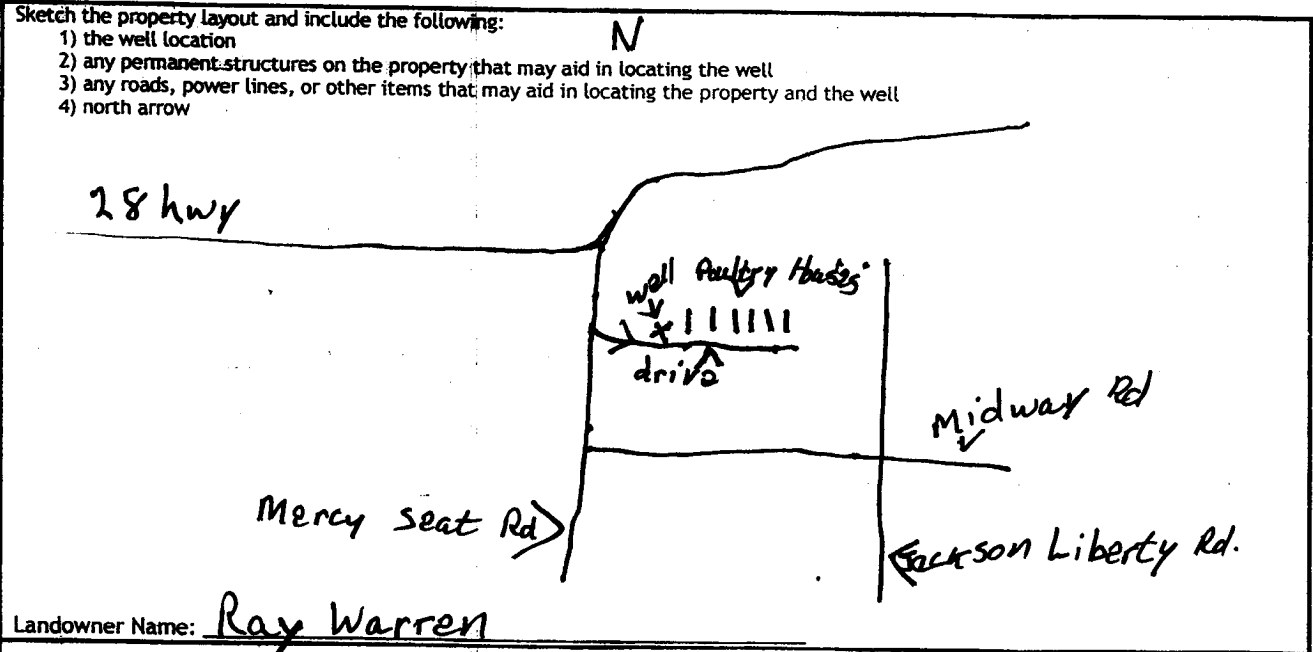

Landowner Name: Ray Warren

I HEREBY CERTIFY that the well/borehole was drilled, constructed, and completed in accordance with all applicable requirements of the Mississippi Department of Environmental Quality and the Mississippi Department of Health regulations, if applicable, and state laws.

BRIAN D. McCLENDON UNR-00000664 2-10-14 Brian McCleendon
 Print Name of Responsible Licensee and License No. Date Signature of Licensee

STATE WELL REPORT

Part 2

Pump Installer's Completion Report
 Mississippi Department of Environmental Quality
 Office of Land and Water Resources
 P.O. Box 2309
 Jackson, MS 39225-2309
 (601)961-5210
 (601) 360-0535 (fax)

County: Copiah
 Permit #: _____
 Driller: GRENN WATER WELL & SUPPLY, INC
 Date completed: 2-3-14
Copy information from block on Part 1

For Office Use Only:

Well #: T27
 Aquifer: _____

This part of the report must be completed by a licensed water well contractor or a licensed pump installer. A copy of Part 1 of the report must be attached and both parts filed with the Department at the above address within 30 days of well completion.

Well Owner Information	Well Location
Owner Name: <u>Ray Warren</u>	Latitude: <u>31° 44' 34"</u> Longitude: <u>90° 31' 55"</u>
Mailing Address: <u>3771 Allied Loop</u>	Method of Lat/Long (check one): Conventional Survey _____, USGS quad _____, Hand-held GPS <input checked="" type="checkbox"/> , Survey-grade GPS _____
<u>Wesson</u> MS <u>39191</u>	<u>SW</u> ¼ <u>SW</u> ¼, Sec <u>14</u> T <u>9N</u> R <u>6E</u>
City State Zip Code	<u>12</u> Miles <u>W</u> of <u>WESSON</u>
Telephone No. <u>(601) 835-1235</u>	(Distance) (Direction) (Nearest Town)

Pump Type (circle one)

Submersible Turbine Air Lift Centrifugal Flowing Well Jet Piston Rotary Other (describe): _____

Date Pump Installed: 2-3-14 Rated Pump Capacity: 55 Gallons Per Minute

Is This Pump (circle one): New Repaired Replacement

Power Type (circle one)

Electric Diesel Gasoline Natural Gas Tractor PTO Windmill Other (describe): _____

Horse Power Rating of Motor: 7.5 Setting Depth: 220 feet Number of Stages: 22

Pump Test Data for Non Flowing Well

Date Well Tested: 2-3-14 Duration of Pump Test (minimum 4 hours): 4 hours

Static Water Level (A): 127 Feet Below Land Surface Pumping Water Level (B): 136 Feet Below Land Surface

Drawdown [(B) - (A)]: 9 Feet Below Land Surface Test Pumping Rate: 55 Gallons Per Minute

Method of measurement (circle one): Steel tape Electric tape Air line Other (describe): _____

Pump Test Data for Flowing Well

Measured shut in head: _____ feet.

Well yielded 55 GPM with a drawdown of 9 feet after 4 hours of pumping

Meter Installation

Meter Manufacturer: _____ Meter Serial Number: _____

Meter Model Number/Name: _____ Type of Meter: _____

Totalizer Register Unit and Multiplier Factor (AF x .001, gal x 1000, etc): _____

Installation Date: _____ Meter installed by: _____

Is This Meter (circle one): New Repaired Replacement

Important: By submitting the above information you are certifying that this meter was installed to manufacturer standards. For agricultural wells, a list of approved meters is on the MDEQ website.

I HEREBY CERTIFY that the above statements are true to the best of my knowledge.

MICHAEL W. KEES RPO-00000801 2-3-14 Michael W. Kees
 Print Name of Pump Installer and License No. (if applicable) Date Signature of Pump Installer

RECEIVED