

**MISSISSIPPI
BOARD OF WATER COMMISSIONERS**
416 North State Street
Jackson, Mississippi 39201

WATER WELL DRILLERS LOG **CODED**

Copiah
U4
9-67

September 8 1967 Burney Water Well Service, Inc. Copiah
date well completed firm name county well located

LANDOWNER: Ernest Munn
Route 1, Box 24-A
Wesson, Miss.
(mailing address)

WELL LOCATION: sec. 23 T. 9 N. R. 7 E.
6 miles West of Wesson
(distance) (direction) (nearest town)

description of formations encountered	depth	
	from	to
Red top soil	0	5
Yellow sand	5	16
Hard chalk	16	18
Grey & Brown clay	18	38
Grey shale or chalk	38	58
Hard formation (rock)	58	74
Grey shale	74	95
Fine sand layers	95	98
All fine sand	98	108
Clay streak	108	114
Sand	114	115
Shale	115	123

WELL PURPOSE: Home
(home, irrigation, municipal, industrial)

WELL COMPLETION DATA:

(1) diameter (inches) 8"

(2) total depth (feet) 123'

(3) static water level (feet) 60' below top of ground.


(4) casing PVC 100'
(material) (depth)
(size) If telescope see back.

(5) screen 6' 100'
(length) (depth to top)
4" Filter Pak Screen
(size) (material)

(6) pump 1/2 600GPH
(HP) (yield gpm)
Electric
(type power)

(7) electric log no
(yes or no)
(organization running log)

(8) how well bottom plugged: Back Wash Valve

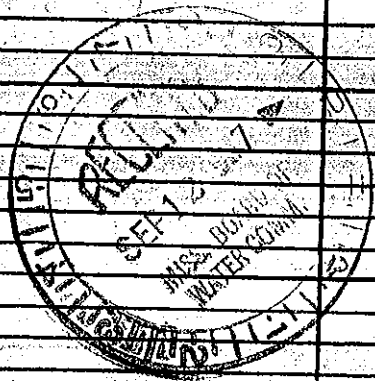

DRILLERS REMARKS: