


COPAH
V-22
1-28-81

MISSISSIPPI
 BOARD OF WATER COMMISSIONERS
 416 North State Street
 Jackson, Mississippi 39201

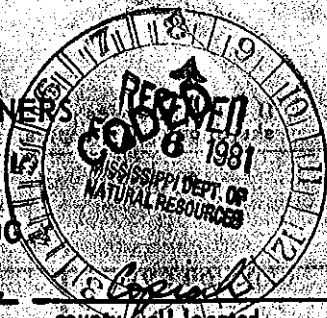

WATER WELL DRILLERS LOG

date well completed 1-28-81 firm name Daye Central Company county well located Copiah

LANDOWNER:	description of formations encountered	from	to
<u>Lincoln Rural Water Assoc.</u>	<u>Sand & Clay gravel</u>	<u>0'</u>	<u>36'</u>
<u>P.O. Box 404</u>	<u>Clay & sand break</u>	<u>36'</u>	<u>55'</u>
<u>Brookline, Miss 39601</u>	<u>Hard Clay</u>	<u>55'</u>	<u>140'</u>
(mailing address)	<u>Sand Clay</u>	<u>140'</u>	<u>185'</u>
WELL LOCATION:	<u>Sand Shale</u>	<u>185'</u>	<u>295'</u>
sec. <u>35</u> T. <u>9</u> N. R. <u>8</u> E.	<u>Clay breaks</u>	<u>295'</u>	<u>300'</u>
5	<u>Sand, Gravel & Clay sh.</u>	<u>300'</u>	<u>417'</u>
miles <u>NE</u> of <u>Wesson</u>			
(distance) (direction) (nearest town)			
WELL PURPOSE: <u>Domestic</u>			
(home, irrigation, municipal, industrial)			
WELL COMPLETION DATA:			
(1) diameter (inches) <u>12"</u>			
(2) total depth (feet) <u>298'</u>			
(3) static water level (feet) <u>81'</u> below top of ground.			
(4) casing <u>Steel</u> , <u>225'</u>			
(material) (depth)			
<u>12"</u> if telescope see back.			
(size) <u>30'</u> , <u>9.8'</u>			
(5) screen <u>60'</u> , <u>225'</u>			
(length) (depth to top)			
<u>8"</u> , <u>Standard Steel</u>			
(size) (material)			
(6) pump <u>50</u> , <u>500 GPM</u>			
(HP) (yield gpm)			
<u>Electric</u>			
(type power)			
(7) electric log <u>Yes</u>			
(yes or no)			
<u>Daye Central Company</u>			
(organization running log)			
(8) how well bottom plugged: <u>Valve</u>			
DRILLERS REMARKS:			

Coded

COPAH
V22
1-28-81
Elog #264

MISSISSIPPI
BOARD OF WATER COMMISSIONERS
416 North State Street
Jackson, Mississippi 39201

WATER WELL DRILLERS LOG

1-28-1981 date well completed
Dayne-Central Company firm name
Copiah county well located

LANDOWNER:	description of formations encountered	from	to
Lynch Rural Water Assoc P.O. Box 404 Brookhaven, Miss. 39601 (mailing address)	Sand & Clay gravel	0'	36'
	Clay & sand breaks	36'	55'
	Hard Clay	55'	140'
	Sand, Clay	140'	185'
	Sand, Shale	185'	295'
	Clay breaks	295'	300'
	Sand, Gravel & Clay, Shale	300'	417'
WELL LOCATION: sec. 35 T 9 N R 8 E 5 S 4 W miles NE of Wesson (distance) (direction) (nearest town)			
WELL PURPOSE: Domestic (home, irrigation, municipal, industrial)			
WELL COMPLETION DATA:			
(1) diameter (inches) 12"			
(2) total depth (feet) 298'			
(3) static water level (feet) 81' below top of ground			
(4) casing (material) steel (depth) 225'			
(5) screen (length) 60' (depth to top) 225'			
(6) pump 50 (HP) 500 GPM (yield gpm)			
(7) electric log (yes or no) Yes			
(8) how well bottom plugged Valve			
DRILLERS REMARKS:			

This well was drilled by
Business of Hensley
in Town of Brookhaven
see 22-79468 &
Order 27, 1980

Jubilee 2/28

Coded

Read
Feb 6, 1981

BUREAU OF NATURAL
BUREAU OF LAND & WATER