

COPIAH

MISSISSIPPI BOARD OF WATER COMMISSIONERS

5-4-66

WATER WELL DRILLERS LOG

Date: 5-4, 1966, Driller: Alvin - DeLoach County Copiah

(Name)

(1) Owner of Land: David Warner

(Name)

Description & Color of Materials
Sand, Clay, Red Clay, Shell, etc.

Thick-
ness
Feet

Depth
Feet

Wesson Miss

(Address)

0 - 52 Clay
52 - 72 white sand

(2) Location: 1/4, 2nd sec. 9, 99

(T)

(R)

2 miles

(direction)

of Strongloze

(Nearest Town)

(3) Topography: Hilly

(Hilly)

(Flat)

(Level)

(4) Purpose of Well:

(Domestic Irrigation
Municipal, Industrial, Other)

Information upon completion of well:

(1) Diameter: 2 inches

(2) Total Depth: 72 feet

(3) Water Level: 62 feet below top of ground

(4) Cased to: 66" Size: 2"

(5) Screen: Size: 2" Length: 5'


(6) Were any formations sealed against pollution?

yes, NO no.

If YES depth of formation

Why

Drillers Remarks:

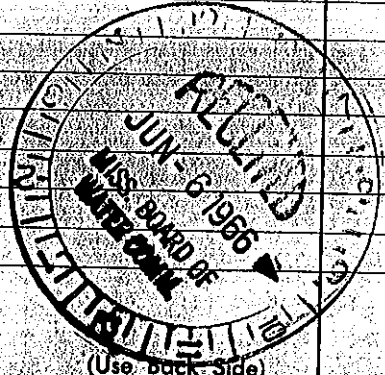

(Use back side)

Well No.

Mail this copy to Board of Water Commissioners 429 Miss. St. Jackson, Miss.