

CODED

W17
M65

MISSISSIPPI
BOARD OF WATER COMMISSIONERS
416 North State Street
Jackson, Mississippi 39201

WATER WELL DRILLERS LOG

Dec. 22 19 67 Burney Water Well Service, Inc. Covich
date well completed firm name county well located


Covich
WA
12-67

LANDOWNER: J. P. Martin, Jr. Route 3, Box 157 Wesson, Miss. (mailing address)	description of formations encountered	from	to
	Red Clay top soil	0	8
	Grey clay	8	18
	Yellow & grey clay	18	45
	Fine sand layers	45	48
	Blue shale or clay	48	52
	Red & blue clay	52	80
	Hard grey shale	80	94
	Blue clay	94	124
	Layers & fine sand	124	150
	Multicolored clay	150	200
	All fine sand	200	205
	Shale	205	222
	All fine sand	222	246
	Tight gumbo	246	261
	Fine sand	261	265
	Tight blue clay	265	344
	Fine sand	344	349
	Shale	349	362
	Sand layers	362	381
	All sand	381	410
	Shale	410	416
	All sand	416	428
	Shale	428	446

WELL LOCATION:
sec. 17 T. 9 N R. 9 E
5 miles East of Beauregard
(distance) (direction) (nearest town)

WELL PURPOSE: Home
(home, irrigation, municipal, industrial)

- WELL COMPLETION DATA:
- (1) diameter (inches) 4"
 - (2) total depth (feet) 446'
 - (3) static water level (feet) 62' below top of ground
 - (4) casing Galv. 4 1/2" (material) (depth) 428'
2" (size) If telescope see back.
 - (5) screen 11' (length) 4 1/2" (depth to top)
2" (size) Johnson S.S. (material)
 - (6) pump 3/4 (HP) 300GPH (yield gpm)
electric (type power)
 - (7) electric log (yes or no)
(organization running log)
 - (8) how well bottom plugged Back wash valve

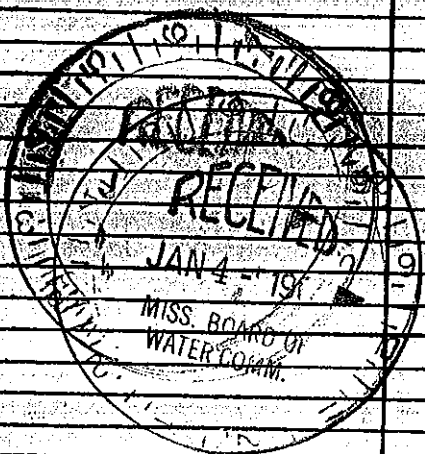

DRILLERS REMARKS: