

COPIAH MISSISSIPPI BOARD OF WATER COMMISSIONERS

W 2001

WATER WELL DRILLERS LOG

8-6-64

Date: 8/6/64 19

Driller: Ray Leharder, Jr. Copiah County

Phone 643-2730

(1) Owner of Land: Cecil B. Keore
 (Name)
 R.H.D. Wesson Moore
 (Address)

(2) Location: 29 4 99
 10 miles N.E. Wesson
 (distance) (direction) (Nearest Town)

(3) Topography: (Hilly) (Flat) (Level)

(4) Purpose of Well: (Domestic) (Irrigation) (Municipal) (Industrial) (Other)


Description & Color of Materials Sand, Clay, Red Clay, Shell, etc.	Thick- ness Feet	Depth Feet
4 yellow clay	4	4
63 all yellow pipe clay		
Black, blue green, red gray with 10" fine water sand at 42'		
well will furnish ample water for home		

Information upon completion of well:

- (1) Diameter 36" inches
- (2) Total Depth 67 feet
- (3) Water Level 42 feet below top of ground
- (4) Cased to 67 Size 74" ID
- (5) Screen: Size None Length

(6) Were any formations sealed against pollution?
 owner will put Cement slab around well
 If YES depth of formation
 Why Sanitation

Drillers Remarks:

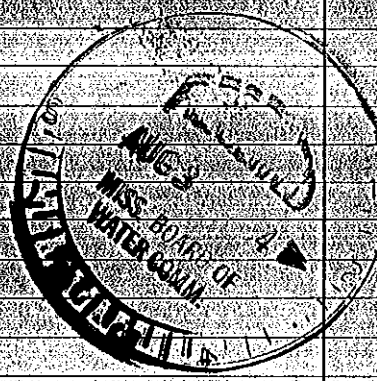

(Use Back Side)

Well No.