

COUINGTON MISSISSIPPI BOARD OF WATER COMMISSIONERS

B7

5-30-61 WATER WELL DRILLERS LOG


Date: 5-30, 1961, Driller: HERMON PARKER County COUINGTON
 (Name)

(1) Owner of Land: <u>Thomas W. HAZI</u> (Name)	Description & Color of Materials Sand, Clay, Red Clay, Shell, etc.	Thick- ness Feet	Depth Feet
<u>mt. olive miss</u> (Address)	<u>Red CHALK</u>	<u>30</u>	<u>30</u>
(2) Location: <u>1/4</u> , <u>1/4</u> , Sec <u>33</u> T. <u>R.</u>	<u>SAND</u>	<u>12</u>	<u>42</u>
<u>5</u> miles <u>North</u> , of <u>Collins</u> (distance) (direction) (Nearest Town)	<u>Blue CHALK</u>	<u>115</u>	<u>157</u>
(3) Topography: <u>FLAT</u> (Hilly) (Flat) (Level)	<u>SAND</u>	<u>28</u>	<u>185</u>
(4) Purpose of Well: <u>Domestic</u> (Domestic Irrigation Municipal, Industrial, Other)			

Information upon completion of well:

- (1) Diameter 2 inches.
- (2) Total Depth 185 feet.
- (3) Water Level 54 feet below top of ground.
- (4) Cased to 185, Size 2"
- (5) Screen: Size 2", Length 5'
- (6) Were any formations sealed against pollution?
 yes, no.

If YES depth of formation _____
 Why _____
 Drillers Remarks: _____

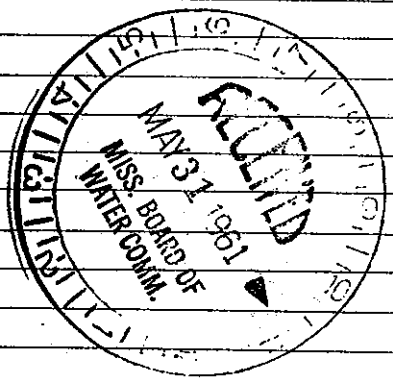

Well No. 24

(Use Back Side)

Mail this copy to Board of Water Commissioners 429 Miss. St. Jackson, Miss