

COVINGTON  
B 203

*need date*

MISSISSIPPI  
BOARD OF WATER COMMISSIONERS  
416 North State Street  
13N Jackson, Mississippi 39201

**WATER WELL DRILLERS LOG**

May 1976  
date well completed

J. R. Green Water Well Drilling  
firm name

COVINGTON  
county well located

**LANDOWNER:**

Edgar Sasser

Route 4 Collins, MS  
(mailing address)

**WELL LOCATION:**

sec. 14 T. 90 S. R. 16 E. of Collins  
(distance) (direction) (nearest town)

**WELL PURPOSE:**

(home, irrigation, municipal, industrial)

**WELL COMPLETION DATA:**

- (1) diameter (inches) 14
- (2) total depth (feet) 82
- (3) static water level (feet) 42 below above top of ground.
- (4) casing PVC 77  
(material) (depth)  
(size) If telescope see back.
- (5) screen 5 77  
(length) (depth to top)  
3" x .008 PVC  
(size) (material)
- (6) pump 1 5  
(HP) (yield gpm)  
220VAC  
(type power)
- (7) electric log NO  
(yes or no)

(organization running log)

(8) how well bottom plugged

**description of formations encountered**

Red Clay

from 0 to 10

" "

10 15

SAND

15 20

" "

20 30

" "

30 36

HARD ROCK

36 37

COARSE SAND

37 40

" "

40 50

Pea GRAVEL

50 60

" "

60 70

" "


70 80

" "

80 82

CHAIN

82

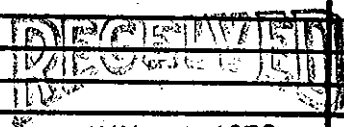

JUN - 1 1976

DRILLERS REMARKS:

MISS. BD. OF WATER COMMISSIONERS