

COUING TON MISSISSIPPI BOARD OF WATER COMMISSIONERS

C4

9-26-61

WATER WELL DRILLERS LOG

Date: 9-26, 1961, Driller: HERMAN PARKER County Carrollton

(Name)

(1) Owner of Land: <u>Pass Speed</u> (Name)	Description & Color of Materials Sand, Clay, Red Clay, Shell, etc.	Thick- ness Feet	Depth Feet
<u>RT #3 Collins, Miss</u> (Address)	<u>Blue CHALK</u>	<u>167</u>	<u>167</u>
(2) Location: <u>1/4, 1/4, Sec. 14 T. R.</u>	<u>SAND</u>	<u>48</u>	<u>215</u>
<u>7</u> miles <u>N-EAST</u> , of <u>Collins</u> (distance) (direction) (Nearest Town)			
(3) Topography: <u>Hilly</u> (Hilly) (Flat) (Level)			
(4) Purpose of Well: <u>Domestic</u> (Domestic Irrigation Municipal, Industrial, Other)			


Information upon completion of well:

- (1) Diameter 2 inches.
- (2) Total Depth 215 feet.
- (3) Water Level 18 feet below top of ground.
- (4) Cased to 215, Size 2"
- (5) Screen: Size 2", Length 5'
- (6) Were any formations sealed against pollution?  
\_\_\_\_\_ yes, No no.

If YES depth of formation \_\_\_\_\_

Why \_\_\_\_\_

Drillers Remarks: \_\_\_\_\_

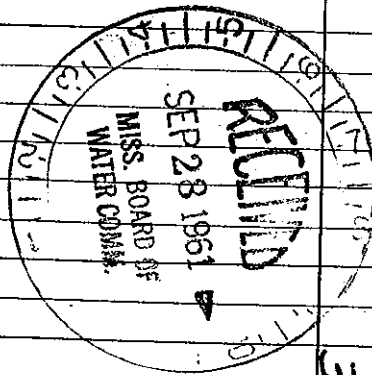

Well No. 35

(Use Back Side)

Mail this copy to Board of Water Commissioners 429 Miss. St. Jackson, Miss.