

CODED

COVINGTON

C24

5-13-76

Flag # 71

5/13/76

MISSISSIPPI BOARD OF WATER COMMISSIONERS
416 North State Street
Jackson, Mississippi 39201

C. P. CLARK

WATER WELL DRILLING
ROUTE 2
AUREL, MISS. 39440

WATER WELL DRILLERS LOG

date well completed

firm name

county well located

C. P. Clark

Covington

LANDOWNER: Miss Forest Comm.

POB Robert E Lee Blvd

Jackson, Miss 39201
(mailing address)

description of formations encountered

from

to

Red Clay

0 9

Sand

9 50

Sand + gravel

50 82

Clay

82 112

Sand + Clay

112 122

Clay

122 174

Rock

174 175

Sand

175 249

Rock

249 250

Clay

250 315

Sand

315 355

Sand

355 380

Soft Clay

380 425

Clay

425 527

Sand

527 590

Clay

590 801

WELL LOCATION:

sec. 15 T. 9 N R. 15 E
12 miles East of N. Olive
(distance) (direction) (nearest town)

WELL PURPOSE: Municipal
(home, irrigation, municipal, industrial)

WELL COMPLETION DATA:

- (1) diameter (inches) 4
- (2) total depth (feet) 588
- (3) static water level (feet) 148 below top of ground
- (4) casing (material) (depth) 541

(size) if telescope see back.

- (5) screen 40 541
(length) (depth to top)

2 1/2 .55 .006
(size) (material)


- (6) pump 5 75
(HP) (yield gpm)

230V 3φ
(type power)

- (7) electric log yes
(yes or no)
Miss Geo Survey
(organization running log)

- (8) how well bottom plugged B W U

DRILLERS REMARKS: Wet Sand
Samples in possession
of Miss State Dept.
Survey - Wilbur Baughman

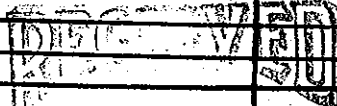

CONF