

#5

State Well Report

Part 1

Mississippi Department of Environmental Quality
Office of Land and Water Resources
P.O. Box 10631
Jackson, MS 39289-0631
(601)961-5210
(601)354-6938 (fax)

For Office Use Only:

Aquifer: _____
Well #: C-50
L. S. Elevation: _____
E-log #: _____

County: Covington
Permit #: _____
Driller: Ray V. West Drilling
Date drilling completed: 11-3-06

State Law requires that this report be prepared by the driller in detail and filed with the Department within 30 days of completion of drilling of the well.

Well Owner Information	Well Location
Owner Name: <u>Blue River LLC</u>	Latitude: <u>31.44</u> " Longitude: <u>89.30</u> "
Mailing Address: <u>152 Old Farm Rd</u>	Method of Lat/Long (circle one): <u>DOT MAP</u> Conventional Survey,
<u>Madison</u> <u>MS</u> <u>39110-8057</u>	USGS quad, Hand-held GPS, Survey-grade GPS
City State Zip Code	<u>NE 1/4 SW 1/4 Sec 15</u> Twn <u>9N</u> Rng <u>15W</u>
Telephone No. <u>(601) 765-6492</u>	Distance Direction Nearest Town
	<u>9</u> Miles <u>E</u> of <u>MT OLIVE</u>

Well Data

Purpose of Well (circle one) Home Industrial Public Supply Irrigation Fish Culture Other: _____

Date well drilling started: 11-2-06 Date well drilling completed: 11-3-06

If flowing, method of flow regulation: Valve _____ Other (describe) _____

Static Water Level: 119 feet above or below (circle one) land surface Date measured: 11-3-06

Method of Measurement (circle one) steel tape electric tape air line other: _____

Hole depth: 218 Well depth: 218 Well grouted to a depth of 10 feet

Type of grout (circle one): Cement Bentonite Mix

Casing length: 208 feet Casing diameter: 4 inches Type of casing: PVC

Screen length: 10 feet Screen diameter: 4 inches Type of screen: PVC slotted

Screen slot size: 10/10 inches Setting depth: From 208 feet to 218 feet

Type of completion (circle all applicable): Gravel packed Underreamed Telescoped Open hole Natural Development

Other (describe): _____

Top of lap pipe or reduction in casing: _____ feet. If telescoped or more than one screen, describe on back of page

Logs run (circle all applicable): No log run Electric Gamma Ray Density Sonic Neutron Other: _____

Name of organization running log(s): _____

I certify that the well was drilled, constructed, and completed in accordance with all applicable requirements of the Mississippi Department of Environmental Quality and/or the Mississippi Department of Health regulations and state laws.

David A. West 0-672
Print Name of Water Well Contractor and License No.

David A. West
Signature of Water Well Contractor


RECEIVED
NOV 28 2006
BY: OLWR

#5

If well telescopes please sketch below and show depths.

C-50

Ground Level

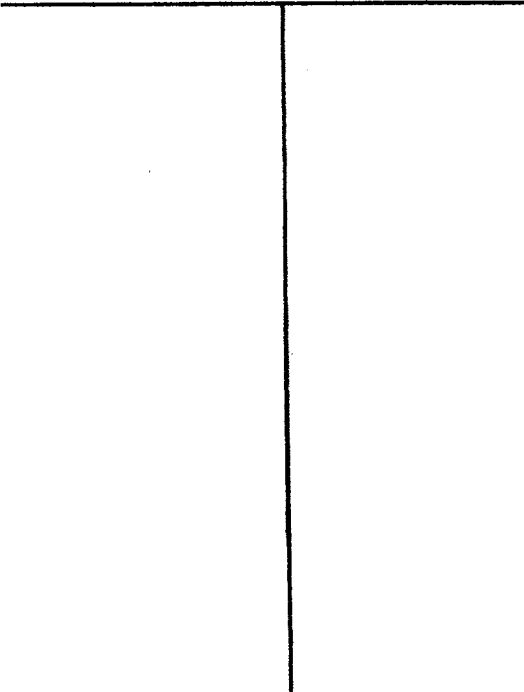


Description of Formations Encountered

From To

Description of Formations Encountered	From	To
Top soil	0	1
SANDY RED CLAY	1	22
SAND & GRAVEL	22	29
CLAY	29	186
SAND	186	218

If more than one screen, show location of each on sketch

Sketch the property layout and include the following: 1) the well location; 2) any permanent structures on the property that may aid in locating the well; 3) any roads, power lines, or other items that may aid in locating the property and the well; 4) indicate direction.

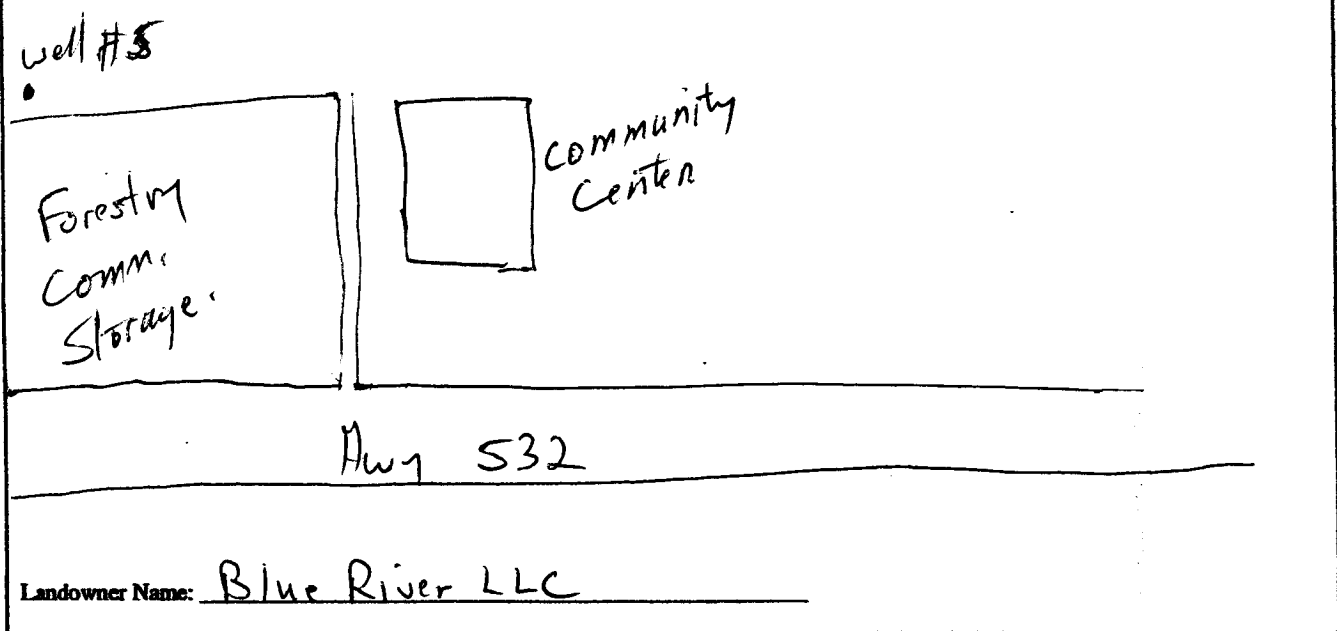

David A. West
Signature of Water Well Contractor

RECEIVED
NOV 28 2006
BY: OLWE

#5

STATE WELL REPORT

Part 2

County: Covington
 Permit #: _____
 Driller: Ray Woot Drilly
 Date completed: 11-3-06

Pump Installer's Completion Report
 Mississippi Department of Environmental Quality
 Office of Land and Water Resources
 P.O. Box 10631
 Jackson, MS 39289-0631
 (601)961-5210
 (601)354-6938 (fax)

For Office Use Only:
 Aquifer: _____
 Well #: C-50
 Elevation: _____

This report should be prepared by the pump installer in detail and filed with the Department within 30 days of the installation of pump.

Well Owner Information	Well Location
Owner Name: <u>Blue River LLC</u>	Latitude: <u>31°44'</u> Longitude: <u>89°30'</u>
Mailing Address: <u>152 Old Farm Rd</u>	Method of Lat/Long (circle one): <u>Conventional Survey</u> <u>DOT MAP</u>
<u>Madison MS 39110-8057</u>	USGS quad, <u>Hand-held GPS</u> , Survey-grade GPS
City State Zip Code	<u>NE 1/4 SW 1/4 Sec 15 Twn 9N Rng 15W</u>
Telephone No. <u>(601) 765-6492</u>	Distance Direction Nearest Town <u>9 Miles E of MTOHUE</u>

Pump Type Circle one	Power Type Circle one
Air Lift Jet <u>Submersible</u>	Diesel Engine Gasoline Engine Natural Gas
Bucket Piston Turbine <u>Electric Motor</u>	Hand Tractor PTO
Centrifugal Rotary Flowing Well	Windmill Other (specify): _____
Other (specify): _____	Horse Power Rating of Motor: <u>5</u>
Date Pump Installed: <u>11-3-06</u>	Setting Depth: <u>160</u> feet
Rated Pump Capacity: <u>55</u> Gallons Per Minute	Number of Stages: _____

Pump Test Data	Method of Measuring Water Level Circle one
Date Well Tested: _____	Air Line Electric Measuring Line Steel Tape
Static Water Level (A): _____ Feet Below Land Surface	Other (specify): _____
Pumping Water Level (B): _____ Feet Below Land Surface	For flowing well, measured shut in head: _____ feet
Drawdown [(B) - (A)]: _____ Feet Below Land Surface	Well yielded _____ GPM with a drawdown of _____ feet after _____ hours of pumping
Test Pumping Rate: _____ Gallons Per Minute	
Duration of Pump Test (minimum 4 hours): _____ hours	

I HEREBY CERTIFY that the above statements are true to the best of my knowledge.
David A. West 0-672 _____
 Print Name of Pump Installer and License No. (if applicable) Signature of Pump Installer

RECEIVED
 NOV 28 2006
 BY: OLWF