


Covington  
C 2069

MISSISSIPPI  
BOARD OF WATER COMMISSIONERS  
416 North State Street  
Jackson, Mississippi 39201

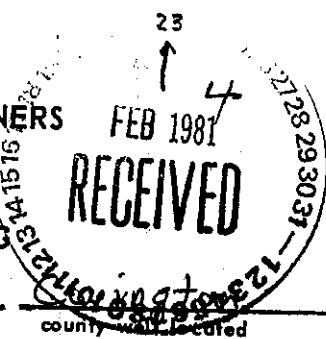

WATER WELL DRILLERS LOG

1/19/81  
JAN 19  
date well completed

1981 Roy V. West Drig  
firm name

Covington  
county well located

LANDOWNER:	description of formations encountered	from	to
Dennis Sullivan Rt 1 Collins (mailing address)			
<b>WELL LOCATION:</b>			
sec. 9 T 9 N R 15 E 20 miles NE of Collins (distance) (direction) (nearest town)			
<b>WELL PURPOSE:</b> HOME (home, irrigation, municipal, industrial)			
<b>WELL COMPLETION DATA:</b>			
(1) diameter (inches) 2"			
(2) total depth (feet) 90'			
(3) static water level (feet) 40' below top of ground.			
(4) casing PVC 85' (material) (depth)			
(size) If telescope see back.			
(5) screen 5' 85' (length) (depth to top)			
14" STAINLESS STEEL (size) (material)			
(6) pump 1 12 (HP) (yield gpm)			
REA (type power)			
(7) electric log NO (yes or no)			
(organization running log)			
(8) how well bottom plugged WASH VALVE			
DRILLERS REMARKS:			

DEPT. OF NATURAL RESOURCES  
BUREAU OF LAND & WATER RESOURCES

FEB 23 1981

RECEIVED