

Covington
 D 28
 6-30-75

MISSISSIPPI
 BOARD OF WATER COMMISSIONERS
 416 North State Street
 Jackson, Mississippi 39201 CODED

WATER WELL DRILLERS LOG

1975
 date well completed 6-30 J. R. GREEN - WATER WELL DRILLING COVINGTON
 RTE. 6, BOX 78A PHONE 425-3237 county well located
 LAUREL, MISS. 39440

LANDOWNER: CHARLES BARNES	description of formations encountered	from	to
Jaylorsville miss	PINK CHALK	0	10
	SAND	10	20
	yellow CHALK	20	22
	yellow CHALK	22	30
	blue	30	40
	blue	40	60
	blue	60	60
	blue	60	80
	blue	80	90
	yellow CHALK	90	98
	SAND	98	100
	blue	100	110
	blue	110	115
	yellow CHALK	115	120

LANDOWNER: CHARLES BARNES

Jaylorsville miss

(mailing address)

WELL LOCATION:


sec. 31 T. 10 N. R. 14 E. 13P
 4 miles south of Jaylorsville
 (distance) (direction) (nearest town)

WELL PURPOSE:

(home) Irrigation, municipal, industrial

WELL COMPLETION DATA:

- (1) diameter (inches) 4
- (2) total depth (feet) 120
- (3) static water level (feet) 42 below above top of ground.
- (4) casing PVC, 100' (material) (depth)
- (size) If telescope see back.
- (5) screen 15' 100' (length) (depth to top)
- 3" x 0.08 PVC (size) (material)
- (6) pump 1 6 (HP) (yield gpm)
- 110 VAC (type power)
- (7) electric log NO (yes or no)
- (organization running log)
- (8) how well bottom plugged

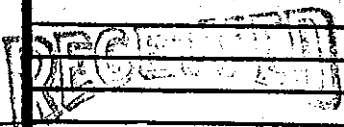

AUG 4 1975

DRILLERS REMARKS:

MISS. BD. OF WATER COMM