

Covington
 D 1999
 8-17-76

MISSISSIPPI
 BOARD OF WATER COMMISSIONERS
 416 North State Street
 Jackson, Mississippi 39201

WATER WELL DRILLERS LOG

8-17-76 date well completed
 13¢
 The Laurel Drilling Co. firm name
 Covington county well located

LANDOWNER: Mr. Sidney Bright
 P.O. Box 2169
 Taylorsville Miss.
 (mailing address)

description of formations encountered	from	to
clay	0	8
fine sand	8	20
clay	20	89
Rock	89	95
fine sand	95	110
bed sand	110	135

WELL LOCATION:

sec. 5 T 9 N R 14 E
 S W
 9 miles E of Collins
 (distance) (direction) (nearest town)

WELL PURPOSE: Home
 (home, irrigation, municipal, industrial)

WELL COMPLETION DATA:


- (1) diameter (inches) 2"
- (2) total depth (feet) 135 ft
- (3) static water level (feet) 35 ft below top of ground.
- (4) casing Plastic, 130 ft
 (material) (depth)
2" if telescope see back.
 (size)
- (5) screen 5 ft, 135 ft
 (length) (depth to top)
2", Plastic
 (size) (material)
- (6) pump 1/2 7
 (HP) (yield gpm)
foot
 (type power)
- (7) electric log
 (yes or no)
✓
 (organization running log)
- (8) how well bottom plugged valve

DRILLERS REMARKS:

RECEIVED
 SEP 22 1976
 MISS. BD. OF WATER COMM

If well telescopes please sketch and show depths.

GROUND LEVEL

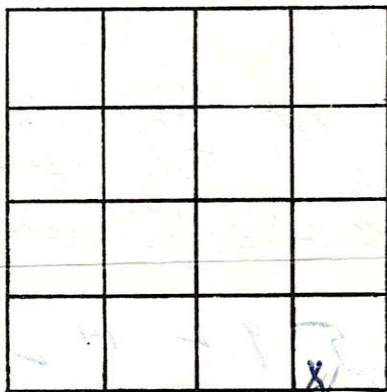

SECTION 5

Please indicate well location X.

ADDITIONAL INFORMATION

If more than one screen, show locations of each on sketch.