

COUINGTON

MISSISSIPPI BOARD OF WATER COMMISSIONERS

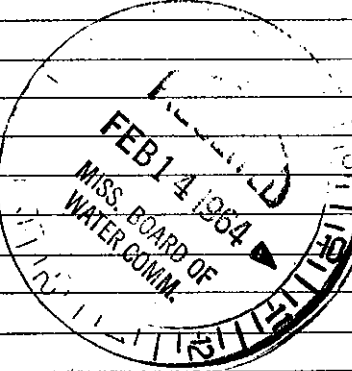
E9

WATER WELL DRILLERS LOG CODED

2-12-64

Date: 2-12-1964, Driller: Jay Latt County Couington

Matthews Butane Gas Co.

(1) Owner of Land	Description & Color of Materials Sand, Clay, Red Clay, Shell, etc.	Thick- ness Feet	Depth Feet
Jasper Mc Rainey (Name)	0-22 RC		
Collins, Miss. (Address)	22-45 RS		
(2) Location: 1/4, 1/4, Sec. 28 T. 8 R. 17	45-105 fine S		
10 miles west, of Collins, (distance) (direction) (Nearest Town)	105-135 W-S		
(3) Topography: Hilly (Hilly) (Flat) (Level)			
(4) Purpose of Well: Domestic (Domestic Irrigation Municipal, Industrial, Other)			
Information upon completion of well:			
(1) Diameter: 2 inches.	CODED		
(2) Total Depth: 13.5 feet.			
(3) Water Level: 69 feet below top of ground.			
(4) Cased to _____, Size _____			
(5) Screen: Size 2, Length 11 ft.			
(6) Were any formations sealed against pollution? _____ yes, _____ no.			
If YES depth of formation _____			
Why _____			
Drillers Remarks: _____			
			Well No.

(Use Back Side)

Mail this copy to Board of Water Commissioners 429 Miss. St. Jackson, Miss