

COVINGTON MISSISSIPPI BOARD OF WATER COMMISSIONERS

~~F 5~~ counting to them call for collection
7-9-62

WATER WELL DRILLERS LOG

CODED 2/21/75

Date: July 9, 1962, Driller: Layne-Central Co. County Covington

(Name)

(1) Owner of Land:	Description & Color of Materials Sand, Clay, Red Clay, Shell, etc.	Thick- ness Feet	Depth Feet
(Name)	soil	1	0-1
Collins, Mississippi	clay stks. brittle & hard	101	102
(Address)	sand	5	107
(2) Location: 1/4, 1/4, Sec. 19, 24, T. 8, R. 16	clay	11	118
_____ miles _____ of _____	sand	37	155
(distance) (direction) (Nearest Town)	sand and gravel	11	166
(3) Topography: _____	clay	4	170
(Hilly) (Flat) (Level)			
(4) Purpose of Well: Industrial			
(Domestic Irrigation Municipal, Industrial, Other)			

Information upon completion of well:


- (1) Diameter 18" inches.
- (2) Total Depth 170' feet.
- (3) Water Level 12' feet below top of ground.
- (4) Cased to 126', Size 10"
- (5) Screen: Size 8", Length 40'
- (6) Were any formations sealed against pollution?
x yes, _____ no.

If YES depth of formation _____ required

Why _____

Drillers Remarks: _____

CODED

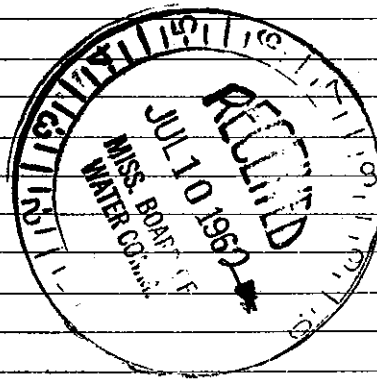

(Use Back Side)

Well No.

Mail this copy to Board of Water Commissioners 429 Miss. St. Jackson, Miss